



LONDON LOCATION
1599 Adelaide St. N., Units 301 & 203
London, ON N5X 4E8
P: 519-471-6667

KITCHENER LOCATION
1415 Huron Rd., Unit 225
Kitchener, ON N2R 0L3
P: 519-725-8093

www.sbm ltd.ca

sbm@sbm ltd.ca

June 2, 2022

SBM-22-0021

York Developments (London) Inc.

303 Richmond Street #201
London, Ontario

Attn: Mr. Carlos Ramirez

Re: Sanitary Servicing Feasibility Study
Proposed 6 Story Apartment Building
415-421 Boler Road, London, ON

1. INTRODUCTION

This Sanitary Servicing Feasibility Study (Study) has been prepared by Strik, Baldinelli, Moniz Ltd. (SBM) for York Developments (London) Inc. to address the sanitary servicing feasibility for the proposed 6 story apartment building development located at 415-421 Boler Road in London, Ontario.

The subject site is approximately 0.325 ha in size. The property borders the Boler Road Right of Way (ROW) to the east, the Byron Baseline Road ROW to the south, and residential properties to the west and to the north. The apartment building is proposed to have 6 floors and 2 floors of underground parking. The proposed development includes 90 residential units with a total floor area of 1,627 m². Please refer to the proposed Overall Site Plan prepared by Philip Agar Architect Inc (AGAR) dated May 27, 2022 attached to this Study.

This Study is to determine the adequacy of the existing sanitary sewer system along Boler Road in support of a Zoning By-Law Amendment (ZBA) for the proposed development to the section of sewer downstream of the intersection of Boler Road and Commissioners Road West.

Design requirements have been based on the City of London Design Specifications & Requirements Manual (DS&RM), updated March 2022.

2. SANITARY SERVICING

As per the attached Site Plan by AGAR, the existing site is composed of three lots with municipal numbers 421, 417, and 415. As stated in the Pre-Consultation Comments by the City of London dated January 28, 2020, the municipal sanitary sewer for the proposed development is the 375mm sanitary sewer within the Boler Road ROW. The size and slope of the sanitary private drain connection (PDC) connecting the proposed building to the mainline sewer will be confirmed during detailed design for Site Plan Application (SPA).

As per the attached City of London Byron Storm & Sanitary Sewer System Plan by R.C. Dunn and Associates dated November 1964 and the City of London Sanitary Sewer Design Sheets 5420 & 5419 dated May 1986, the subject site is located between manhole 60 and manhole 59.

This Study is to determine the adequacy of the existing sanitary sewer on Boler Road between the subject site to the sanitary sewer downstream of the Boler Road and Commissioners Road West intersection in support of a Zoning By-Law Amendment (ZBA) for the proposed development. For the purposes of this Study, the following assumptions have been made:

- Detailed design of the site's proposed servicing will take place at the time of Site Plan Approval application.
- The subject site area is approximately 0.325 ha and is proposed to consist of a 90-unit, 6 story apartment as per the Site Plan prepared by AGAR, dated May 27, 2022.
- The site's occupancy load of 144 people has been calculated per:

- High density residential classification for the proposed apartment building of 1.6 people/unit (90 units * 1.6 ppl/unit = 144 ppl).
- The area considered in this Study is limited to the areas shown on the attached Sanitary Catchment Area Study Limit drawing. The northern study limit is sanitary manhole 50 (BY581) on Commissioners Road West and the most southern sanitary manhole is BY1900.
- As the latest available Boler Road sanitary design sheets are out-of-date (circa 1977 & 1968) and additional development has taken place since, the upstream sanitary catchment areas and populations were determined by using the City of London Locates Mapping to delineate which catchment areas were tributary to the Boler Road sanitary sewer and the associated populations were determined by performing dwelling counts within each catchment area. Populations were also calculated for other areas including schools and commercial areas based on densities specified in the DS&RM. Details showing the catchment area measurements and catchment area population calculations can be found attached.
- The City of London Byron Storm & Sanitary Sewer System Plan by R.C. Dunn and Associates dated November 1964 and the City of London Sanitary Sewer Design Sheets 5420 & 5419 dated May 1986 were used to determine the downstream sanitary catchment areas and associated areas and existing sanitary sewer specifications. It is assumed that the drawings are representative of the latest sanitary drainage area parameters and sanitary sewer specifications including but not limited to drainage areas, pipe diameters, and pipe slopes.
- Adjustments to downstream catchment area populations were confirmed using the City of London Mapping website to ensure the correct number of units for each catchment. If the number of units/population calculated based on the City of London Mapping was greater than the number of units/population reported in the sanitary design sheet, the larger of the two was considered for this Study which is noted on the attached Sanitary Design Sheet by SBM.
- Populations and sanitary drainage areas for the future Boler Heights Subdivision (39T-15503) were included within this Study. Details can be found on the attached Upstream Sanitary Catchment Area Detail #3
- As shown on the attached Boler Road 250mm Sanitary Force main Detail, there is an existing 250mm sanitary force main which is connected to a "Temporary Pumping Station" located within the Westfield Village Estates subdivision as shown on the attached City of London record drawing 24382. The pumping station and force main formerly serviced the subdivision and the 250mm connected to the gravity sewer on Boler Road. However, it has been confirmed by the City of London Engineering department that the force main is no longer operational and therefore was not considered within the scope of this Study.
- Assumed 4 persons per single family residential dwelling based on the original Boler Road sanitary sewer design sheets provided attached (whereas 3 people per unit is the standard within the current DS&RM).
- A population of 100 people/hectare has been assumed for existing commercial properties.
- A population of 600 people has been assumed for existing elementary schools.
- A flow criterion of 230 L/capita/day has been used to quantity sewage flows for the proposed development and all other sanitary drainage areas in alignment with current City of London DS&RM standards.
- An uncertainty factor of 1.1 has been applied to all sanitary sewage calculations in this study.
- An infiltration allowance of 8640 L/ha/day was included as per the DS&RM.
- Only dry weather flows were considered in this Study. Evaluation of wet weather flows was not included and is considered outside the scope of this Study.

The proposed flows from the subject site are shown on the Sanitary Sewer Design Sheet attached to this Study. Using a flow of 230 L/capita/day as per the DS&RM for the proposed site's occupancy load of 144 people, the anticipated peak sanitary flow for the proposed development is 1.77 L/s. When combined with infiltration, this results in a total peak flow of 1.80 L/s. A sanitary sewer PDC connecting to the 375mm sewer on Boler Road will be designed during detailed design for SPA to accommodate the expected flows.

As shown on the attached Sanitary Sewer Design Sheet, the existing sanitary sewers on Boler Road downstream of the proposed development, to the intersection of Boler Road and Commissioners Road West all have adequate capacity to convey the increase in flows from the proposed 6 story apartment building located at 415-421 Boler Road. The sanitary sewer with the highest calculated percentage full is located between manholes 50 and 51 with a total flow of 90.83 L/s and a capacity of 148.23 L/s resulting in the sewer being calculated at 61.27% full.

Based on the above, the City's existing sanitary sewer infrastructure within the study area appears to have sufficient capacity to accommodate the proposed development.

3. LIMITATIONS

This Study was prepared by SBM for York Developments (London) Inc. and the City of London. Use of this Study by any third party, or any reliance upon its findings, is solely the responsibility of that party. SBM accepts no responsibility for damages, if any, suffered by a third party as a result of decisions made or actions undertaken as a result of this Study. Third party use of this Study, without the express written consent of the Consultant, denies any claims, whether in contract, tort, and/or any other cause of action in law, against the Consultant.

All findings and conclusions presented in this Study are based on site conditions as they appeared in the information presented to SBM and related to in this document. This Study is not intended to be exhaustive in scope, or to imply a risk-free development. It should be recognized that the passage of time may alter the opinions, conclusions, and recommendations provided herein, as well as any changes in the layout of the development.

The design was limited to the documents referenced herein and SBM accepts no responsibility for the accuracy of the information provided by others. All designs and recommendations presented in this Study are based on the information available at the time of the review.

This document is deemed to be the intellectual property of SBM in accordance with Canadian copyright law.

4. CLOSURE

We trust this Study meets your satisfaction. Should you have any questions or require further information, please do not hesitate to contact us.


Respectfully submitted,

Strik, Baldinelli, Moniz Ltd.

Planning • Civil • Structural • Mechanical • Electrical



Ryan Frouws, P.Eng.
Civil Eng. II, Project Lead

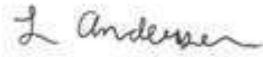

Lauren Andersen
Civil Engineering Intern

Encl: Overall Site Plan prepared by Philip Agar Architect Inc. dated May 27, 2022
City of London Record Drawing 5415 Byron Storm & Sanitary Sewer System Plan by R.C. Dunn and Associates dated November 1964
City of London Record Drawings 5419 & 5420 Sanitary Sewer Design Sheets dated May 1986
City of London Record Drawing 7079 Boler Road Improvements Sanitary Design Area by R.C. Dunn and Associates dated March 1977
City of London Record Drawing 24382 Westfield Village Estates Interim Sanitary Drainage Area Plan
Email Confirmation from the City of London
City of London Mapping Markups by SBM
Sanitary Service Design Sheet by SBM Dated June 2022






Site data

* = BEFORE ROAD WIDENING

1. GROSS SITE AREA:	4,464 s.m. (0.446 HECTARES)	AFTER RW : 3,261 s.m. (0.326 HECTARES)
2. BUILDING AREA (B.A.):	1,612 s.m.	
3. ASPHALT AREA:	1,004 s.m.	

ITEM	A	ZONING REQUIREMENTS	PROPOSED APARTMENTS
4.	ZONES	R1-8 (CURRENT)	TYPE 2 BONUS
5.	LOT AREA (MIN.)	—	4,464 s.m. *
6.	LOT FRONTAGE (MIN.)	—	46.214 m
7.	FRONT YARD SETBACK	—	1.312 m
8.	REAR YARD SETBACK	—	10.709 m
9.	SIDE YARD SETBACK	—	3.861 m
10.	EXTERIOR YARD SETBACK	—	0.478 m
11.	LANDSCAPED OPEN SPACE	—	41% *
12.	LOT COVERAGE MAX. (ON GROSS SITE)	—	36% *
13.	HEIGHT (MAX.)	6 STOREYS	6 STOREYS ~23m
14.	DENSITY	75 UNITS/HECTARE	215 UPH
15.	UNITS	88 UNITS	90 UNITS
16.	PARKING REQ.	1.25/UNIT = 113 PARKING REQ'D INCLUD. 3 TYPE A + 2 TYPE B B/F (1+3% B/F PARKING REQUIRED) 0.75 SECURE BICYCLE SPACES= 68	25 SURFACE 88 UNDERGROUND = 113 PARKING SPACES TOTAL INCLUDING 3 TYPE A B/F 3 TYPE B B/F 70 SECURE BICYCLE SPACES

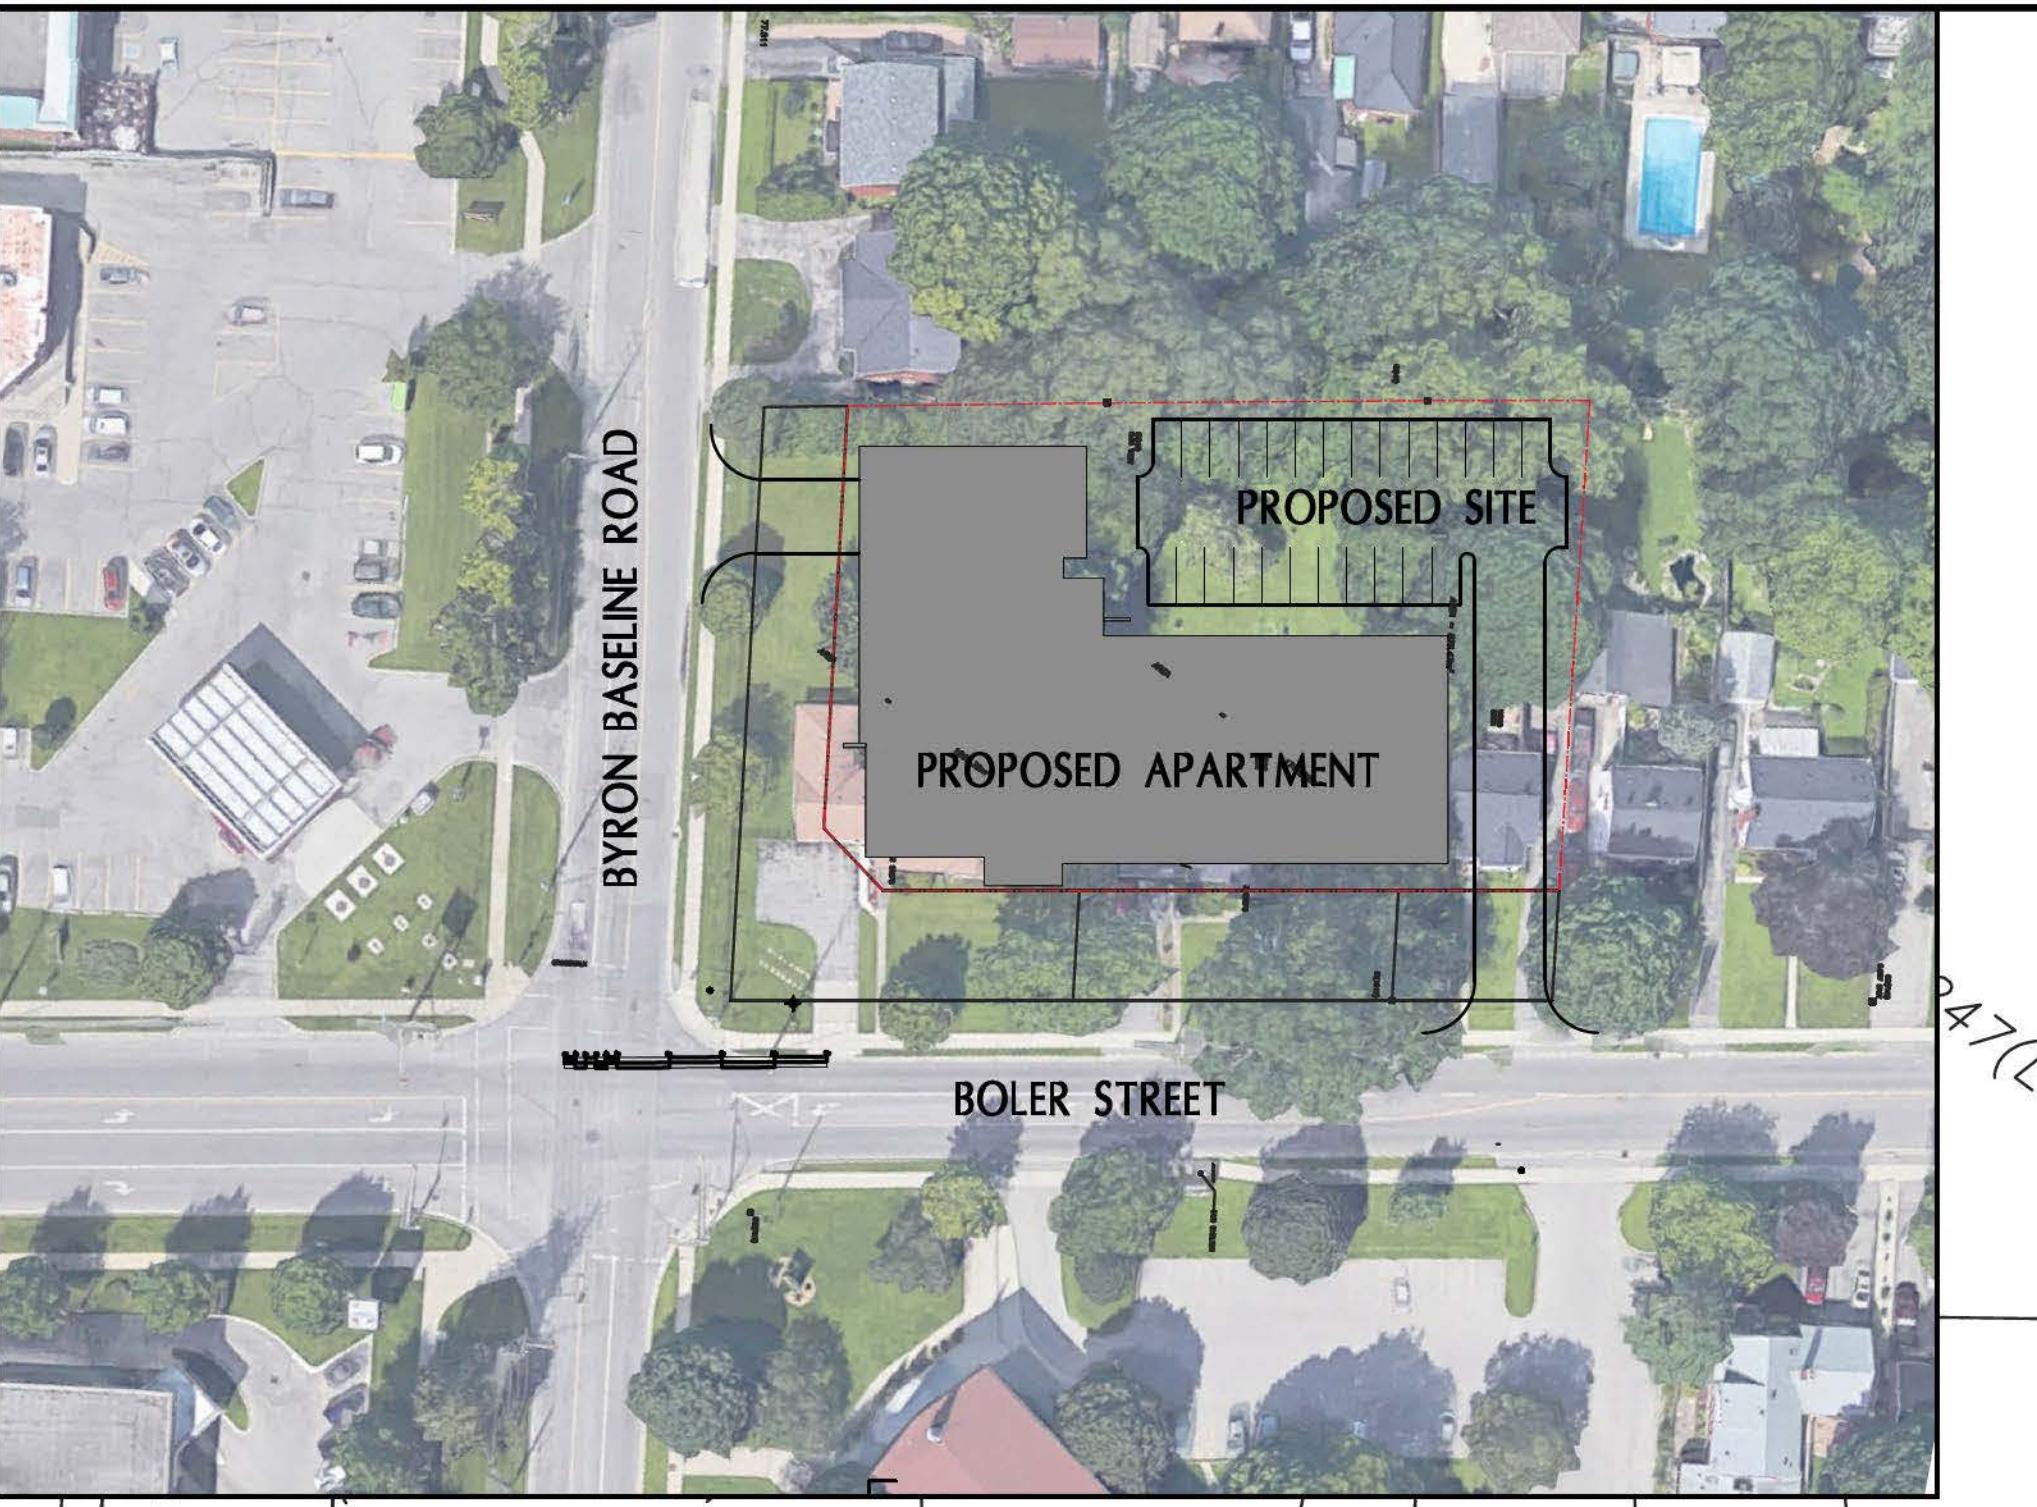 

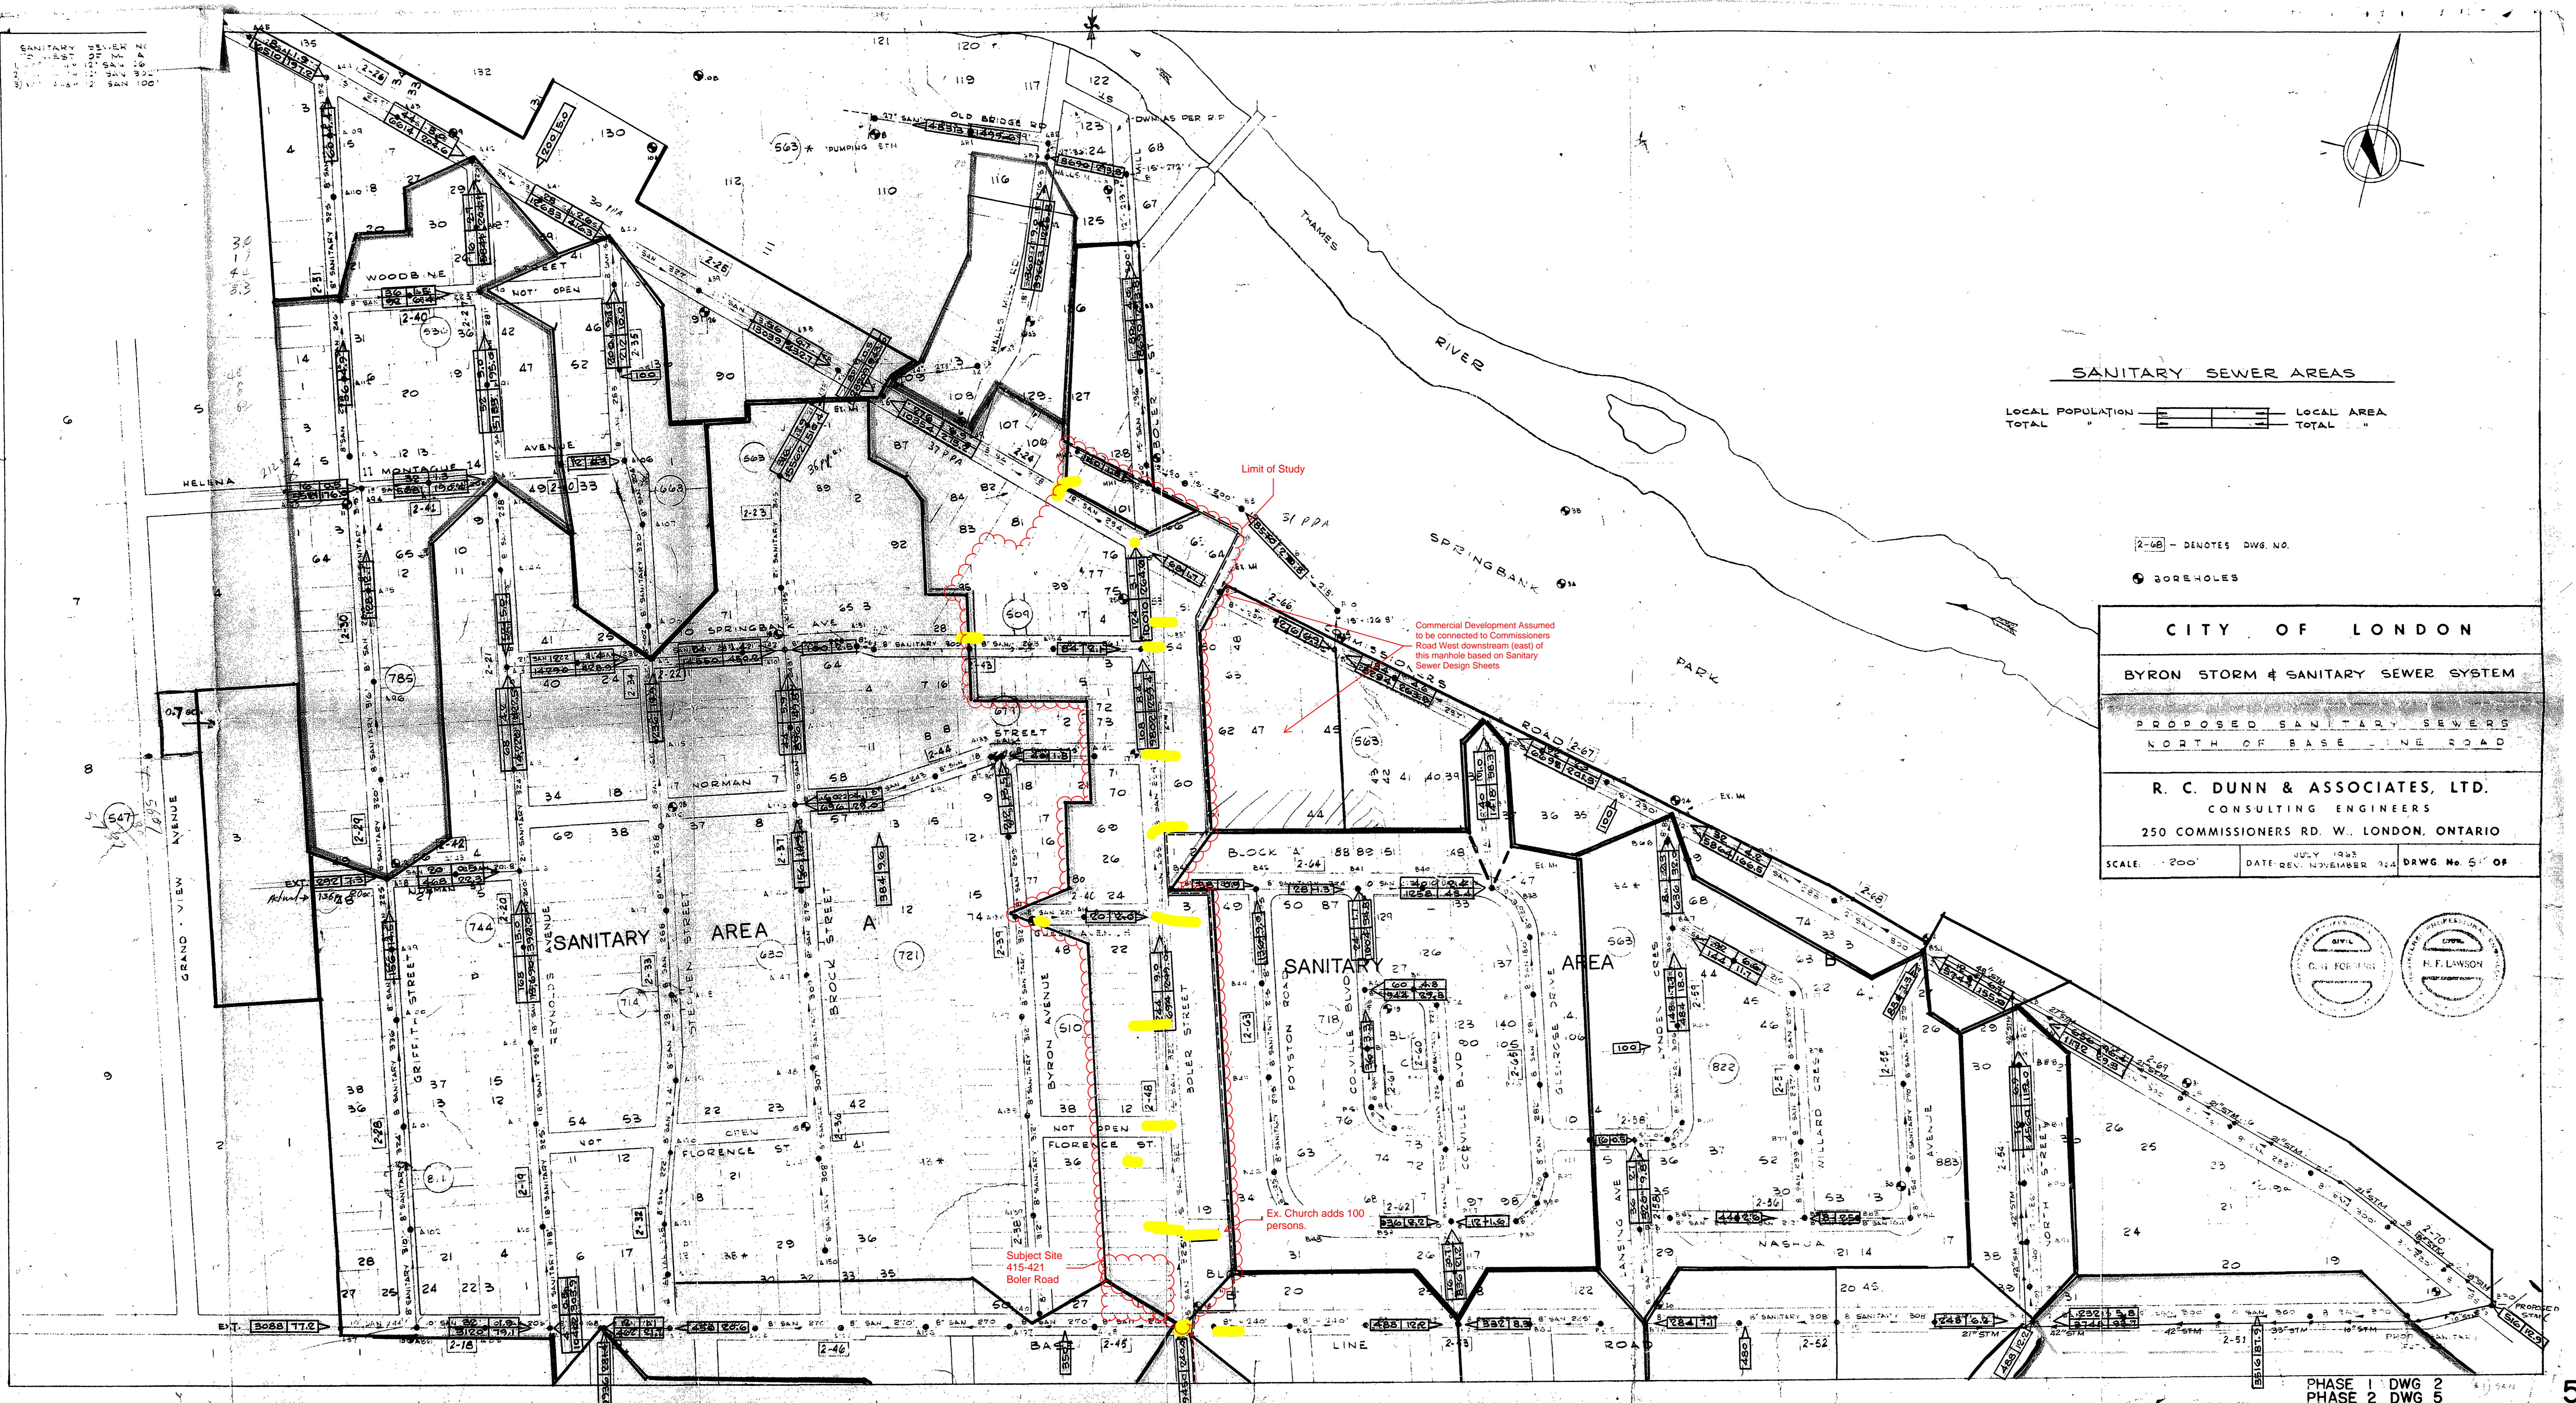

545

POPULATION DENSITIES:-

SINGLE FAMILY LOTS 4 PEOPLE
DUPLEX LOT 8
APTS: BACK 1/2"
1 BD. RM. 2/2"
2 BD. RM. 3/2"

LATERALS - AREA 'A' - ①

CITY OF LONDON
CITY ENGINEERS DEPARTMENT
SANITARY SEWER DESIGN SHEET

"AS BUILT"
PROJECT BYRON SEWERS
FILE NO. SHEET 1 OF 2
SANITARY AREA LATERAL 'A'
DESIGNED BY CGE/HEL CHECKED BY CGF
DATE MAY 1968

SEWER LOCATION			AREA			POPULATION			SEWAGE FLOW			SEWER DESIGN			PROFILE												
DWG	STREET	FROM	TO	NET OR GROSS	DIMENSIONS	AA ACRES	SA ACRES	PER ACRE	NO OF LOTS	PER LOT	A POP.	E POP.	INFILT. C.F.S.	SEWAGE C.F.S.	TOTAL C.F.S.	SIZE IN. INS.	S %	n	CAP. F.P.S.	LOSSES IN M.H. SEWER	FALL IN FEET	LENGTH feet	INVERT ELEV. U.S. D.S.				
7	WAYNE ROAD	BOLER	JELLINE	GR.	4.5 2.5	.20	.4	.80	.01	.03	.04	.00	.194	.005	.14	1.4	1.02	2.96	2.14	1.02	1.02	4.00	302.79	858.79			
16	JELLINE CR.	WAYNE	LOLA		7.3 1.8	.25	.4	.100	.02	.09	.11	.00	.94	.005	.10	1.03	1.05	1.02	2.73	1.80	296.1	854.85	853.05				
8	REGIS AVE.	-	REGIS PL.		1.9 1.9	.4	.4	.10	.01	.01	.02	.00	.204	.005	.14	1.49	1.39	2.96	2.15	1.02	2.25	1928.8	850.58	848.33			
"	"	N. LIMIT	"		2.5 2.5	.7	.28	.001	.01	.02	.00	.00	.97	.005	.10	1.03	1.02	2.96	2.15	1.02	1.32	295.8	848.10	846.78			
9	"	PLACE	REGIS AVE. W. LIMIT		1.8 6.2	.9	.36	.80	.01	.04	.05	.00	.100	.005	.14	1.05	1.02	2.96	2.15	1.02	1.95	3.00	846.10	846.10			
10	EASEMENT	"	PL. SCHOOL		1.6 7.8	.2	.8	.88	.01	.04	.05	.00	.069	.005	.087	1.17	1.02	2.96	2.15	1.02	1.48	2.38	843.47	841.39			
11	LOLA ST.	SCHOOL	JELLINE		6.2 14.0	.100	.188	.002	.01	.02	.012	.00	.063	.005	.083	1.30	1.02	2.96	2.15	1.02	2.86	118.3	835.27	833.01			
15	JELLINE CR.	LOT 6	LOLA		3.1 3.1	.13	.52	.52	.001	.03	.04	.00	.048	.005	.072	1.02	1.02	2.96	2.15	1.02	2.72	164.3	828.28	825.56			
11	LOLA ST. AVE.	JELLINE	BLAKE		0.9 26.6	.4	.16	.436	.004	.02	.024	.00	.063	.005	.083	1.12	1.02	2.96	2.15	1.02	2.98	185.0	819.92	816.94			
17	COLLINGWOOD	LOT 4	"		5.6 5.0	.19	.76	.001	.03	.04	.00	.017	.005	.113	1.34	1.02	2.96	2.15	1.02	2.91	187.8	812.65	809.74				
"	"	W. LIMIT	"		1.0 1.0	.3	.12	.001	.01	.02	.00	.005	.107	.005	.107	1.02	1.02	2.96	2.15	1.02	2.46	182.5	816.16	803.70			
14	BLAKE ST.	COLLINGWOOD	LOLA		6.4 13.2	.27	.108	.196	.002	.01	.012	.00	.142	.005	.125	1.90	1.02	2.96	2.15	1.02	2.46	182.5	816.16	803.70			
13	BLAKE ST.	LOT 5	BLAKE		2.6 2.6	.5	.20	.20	.001	.01	.002	.00	.301	.005	.181	1.55	1.02	2.96	2.15	1.02	2.46	182.5	816.16	803.70			
13	BLAKE ST.	LOT 7	LOLA		5.4 8.0	.16	.64	.84	.001	.04	.005	.00	.049	.005	.073	1.03	1.02	2.96	2.15	1.02	2.46	182.5	816.16	803.70			
45,46	BASE LINE ROAD	BOLER	STEPHEN	COMMERCIAL	350 20.4 20.6	.25	.100	.450	.004	.02	.020	.00	.042	.005	.068	1.59	1.02	2.96	2.15	1.02	2.46	182.5	816.16	803.70			
18	"	"	STEPHEN	BELVEDERE	1.1 21.7	.3	.12	.462	.004	.02	.020	.00	.332	.005	.190	1.62	1.02	2.96	2.15	1.02	2.46	182.5	816.16	803.70			
28,29	GRIFFITH ST.	BASE LINE	NORMAN		14.5 14.5	.39	.156	.156	.002	.009	.011	.00	.047	.005	.085	2.45	1.02	2.96	2.15	1.02	2.46	182.5	816.16	803.70			
42	NORMAN ST.	GRIFFITH	REYNOLDS	EXT. 7.3 AC	6.0 27.8	.40	.5	.202	.468	.005	.026	.031	.00	.157	.005	.387	2.52	1.02	2.96	2.15	1.02	2.46	182.5	816.16	803.70		
21	REYNOLDS RD.	HELENA	MONTAGUE	SPRINGBANK	5.0 5.0	.13	.52	.52	.001	.008	.003	.00	.047	.005	.072	0.83	1.02	2.96	2.15	1.02	2.46	182.5	816.16	803.70			
32,33,34	STEPHEN ST.	BASE LINE	SPRINGBANK		19.9 19.9	.59	.236	.236	.003	.014	.017	.00	.044	.005	.069	1.36	1.02	2.96	2.15	1.02	2.46	182.5	816.16	803.70			
36,37	BROCK ST.	BASE LINE	NORMAN		14.9 14.9	.44	.156	.156	.002	.009	.011	.00	.054	.005	.101	1.60	1.02	2.96	2.15	1.02	2.46	182.5	816.16	803.70			
37	"	"	NORMAN	SPRINGBANK	5.9 49.8	.11	.44	.896	.008	.048	.050	.00	.043	.005	.124	1.88	1.02	2.96	2.15	1.02	2.46	182.5	816.16	803.70			
38,39	BYRON BLVD.	BASE LINE	NORMAN		13.5 13.5	.53	.212	.212	.002	.012	.014	.00	.065	.005	.084	1.47	1.02	2.96	2.15	1.02	2.46	182.5	816.16	803.70			
44	NORMAN ST.	BOLER	BYRON		1.8 1.8	.10	.40	.40	.002	.002	.002	.00	.058	.005	.080	0.87	1.02	2.96	2.15	1.02	2.46	182.5	816.16	803.70			
"	"	"	BYRON	BLAKE	P.U.C. 9.6 AC	.41	.29.0	.40	.15	.60	.696	.005	.038	.043	.00	.048	.005	.072	1.87	1.02	2.96	2.15	1.02	2.46	182.5	816.16	803.70
TOTAL P.D.C.'S = 431 2086																											

LATERALS - AREA 'A' - ②

CITY OF LONDON
CITY ENGINEERS DEPARTMENT
SANITARY SEWER DESIGN SHEET

"AS BUILT"
PROJECT BYRON SEWERS
FILE NO. SHEET 2 OF 2
SANITARY AREA LATERAL 'A'
DESIGNED BY CGE/HEL CHECKED BY CGF
DATE MAY 1968

SEWER LOCATION			AREA			POPULATION			SEWAGE FLOW			SEWER DESIGN			PROFILE	
----------------	--	--	------	--	--	------------	--	--	-------------	--	--	--------------	--	--	---------	--

TRUNKS - AREA 'A' - ①

CITY OF LONDON
CITY ENGINEERS DEPARTMENT
SANITARY SEWER DESIGN SHEET

POPULATION DENSITIES:-

SINGLE FAMILY LOTS 4 PEOPLE
DUPLEX LOT 8 "
APTS: BACK 1 BD. RM. 1/2"
1/2" 2 BD. RM. 2/3" 3/4"

"AS BUILT"
PROJECT BYRON SEWERS
FILE NO. SHEET 1 OF 3
SANITARY AREA 'A'
DESIGNED BY CGE/HEL CHECKED BY CGF
DATE MAY 1968

DWG	SEWER LOCATION			AREA			POPULATION			SEWAGE FLOW			SEWER DESIGN			PROFILE							
	NR	STREET	FROM	TO	NET OR GROSS	DIMENSIONS	Δ A ACRES	Σ A ACRES	PER ACRE	NO. OF LOTS	PER LOT	A POP.	Σ POP.	INFILT. C.F.S.	SEWAGE C.F.S.	TOTAL C.F.S.	SIZE IN.	S %	N	CAP. F.P.S.	VELOCITY IN M.H. SEWER	FALL IN feet	LENGTH IN U.S.
11	LOLA ST.	BLAKE (26)	BELVEDERE (25)	GR.	0.9	48.5	3	4	18	728	0.08	0.48	0.48	12	0.53	0.015	0.260	2.86	1.86	1.62	311.4	818.54	816.92
12	BELVEDERE AVE.	LOLA (25)	24	EXT. 220.7 AC	1.0	270.8	40	7	4	8828	0.46	4.00	4.46	15	0.61	"	4.39	3.64	(H.0.06)	1.52	263.8	812.00	810.48
"	"	24	EXT. 7.0 AC	1.8	219.6	40	10	28	9924	0.47	4.13	4.60	18	0.33	"	5.23	2.90	1.04	319.4	810.21	809.17		
"	"	23	BASE LINE (28)	1.8	281.4	8	32	9936	0.47	4.15	4.62	18	0.24	"	4.45	2.61	(H.0.05)	0.69	292.3	809.05	808.36		
18	BASE LINE RD.	87	GRIFFITH (86)	EXT. 77.2 AC	0.9	78.1	40	3	12	3102	0.16	1.50	1.66	10	1.63	"	2.42	4.19	3.18	198.9	822.42	819.24	
"	"	86	86	86	0.5	78.6	2	8	3102	0.16	1.50	1.66	10	1.51	"	2.37	4.12	3.97	256.6	819.13	815.16		
"	"	85	REYNOLDS (85)	85	0.5	79.3	3	12	3102	0.16	1.52	1.68	10	1.61	"	2.40	4.16	3.21	203.0	815.12	811.91		
18	"	"	BELVEDERE REYNOLDS (87)	87	0.8	36.9	1	4	1602	0.51	4.32	4.83	18	0.21	"	4.17	2.73	(H.0.12)	0.34	170.0	808.01	807.73	
19	REYNOLDS RD.	BASE LINE (21)	20		1.5	385.5	5	20	13542	0.64	5.00	6.04	18	0.38	"	5.61	3.42	(H.0.19)	1.20	323.2	807.62	806.42	
"	"	20	19		3.0	387.0	12	48	13590	0.64	5.10	6.04	18	0.40	"	6.17	3.50	1.47	323.2	806.21	804.80		
"	"	19	18		3.0	392.0	8	32	13622	0.65	5.10	6.07	18	0.57	"	6.87	3.94	1.57	245.6	804.51	803.82		
20	"	18	17		3.0	393.0	10	40	13662	0.65	5.14	6.09	18	0.40	"	5.75	3.44	(H.0.04)	1.22	306.0	803.02	801.92	
"	"	17	NORMAN (16)	2.5	396.0	7	28	13692	0.60	5.45	6.11	18	0.44	"	6.04	3.46	1.05	245.3	801.09	800.04			
"	"	16	NORMAN (16)	2.1	402.4	8	32	14190	0.70	5.58	6.28	21	0.38	0.013	9.75	4.05	1.18	314.6	798.28	797.16			
21	"	15	SPRINGBANK (14)	2.1	402.5	9	36	14026	0.70	5.62	6.32	21	0.28	"	8.37	3.39	0.90	323.3	796.00	795.16			
22	SPRINGBANK AVE.	REYNOLDS (13)	13		0.7	428.2	2	8	14286	0.78	5.63	6.35	21	0.34	"	9.73	3.63	0.74	220.5	794.55	793.81		
"	"	13	STEPHEN (10)	13	0.7	428.9	1	4	14290	0.78	5.65	6.35	21	0.36	"	10.73	3.62	1.07	237.6	791.87	790.82		
"	"	11	STEPHEN (12)	11	0.7	419.5	3	12	14538	0.75	5.12	6.47	21	0.34	"	9.23	3.62	0.94	282.2	789.94	789.26		
"	"	11	BROCK (10)	11	0.7	450.2	3	12	14550	0.75	5.72	6.47	21	0.39	"	9.88	3.82	0.58	142.6	788.61	788.63		
23	EASEMENT	SPRINGBANK (10)	9		3.5	566.0	40	0	140	15686	0.84	6.11	6.95	21	0.47	"	10.89	4.51	0.86	152.6	781.13	780.87	
"	"	9	8		3.6	569.6	40	0	144	15820	0.85	6.18	7.03	21	0.47	"	10.89	4.51	1.63	348.4	786.18	784.55	
"	"	8	7-1		0.8	510.4	40	1	32	15862	0.85	6.18	7.03	21	0.40	"	10.02	4.62	0.76	190.9	784.12	783.57	
"	"	7-1	ROAD	7-1	510.4	1	15862	0.85	6.18	7.03	21	0.43	"	10.40	4.69	0.81	191.6	781.85	781.64				
50	BOLER ROAD	66	65	EXT. 139.0 AC	18.0	157.0	40	3	5580	0.26	0.82	3.08	12	1.15	0.015	3.32	4.22	3.40	300.1	874.51	871.11		
"	"	65	WAYNE (64)	17.0	174.0	2	680	6960	0.29	3.08	3.37	12	1.17	"	3.35	3.30	3.47	299.9	869.37	865.92			
"	"	WAYNE (64)	63	EXT. 17.0 AC	1.5	157.5	3	712	1672	0.32	3.34	3.60	15	1.51	"	6.90	4.85	4.46	298.9	863.89	862.45		

TOTAL P.D.C.'S = 115 Total

TRUNKS - AREA 'A' - ②

CITY OF LONDON
CITY ENGINEERS DEPARTMENT
SANITARY SEWER DESIGN SHEET

POPULATION DENSITIES:-


SINGLE FAMILY LOTS 4 PEOPLE
DUPLEX LOT 8 "
APTS: BACK 1 BD. RM. 1/2"
1/2" 2 BD. RM. 2/3" 3/4"

"AS BUILT"
PROJECT BYRON SEWERS
FILE NO. SHEET 2 OF 3
SANITARY AREA 'A'
DESIGNED BY CGE/HEL CHECKED BY CGF
DATE MAY 1968

DWG	SEWER LOCATION			AREA			POPULATION			SEWAGE FLOW			SEWER DESIGN			PROFILE							
	NR	STREET	FROM	TO	NET OR GROSS	DIMENSIONS	Δ A ACRES	Σ A ACRES	PER ACRE	NO. OF LOTS	PER LOT	A POP.	Σ POP.	INFILT. C.F.S.	SEWAGE C.F.S.	TOTAL C.F.S.	SIZE IN.	S %	N	CAP. F.P.S.	VELOCITY IN M.H. SEWER	FALL IN feet	LENGTH IN U.S.
48	BASE LINE (58)	58	+ CHURCH (100)	58	3.0	223.0	5	120	9570	0.40	4.00	4.40	15	1.03	"	5.71	2.55	3.30	323.1	824.13	821.43		
"	"	58	57																				

CITY OF LONDON
CITY ENGINEERS DEPARTMENT
SANITARY SEWER DESIGN SHEET

SEWER AREA NO.	LOCATION	FROM TO	AREA NET OF GROSS	POPULATION		INITIAL SEWAGE FLOW	SEWAGE FLOW	SEWER DESIGN PROFILE
				△ A	△ A			
SAN 1	SA 100	SA 100	SA 100	2.42	2.42	1	4	4
SA 100	SA 100	SA 100	SA 100	3.30	5.72	10	3	10
SA 100	SA 100	SA 100	SA 100	2.71	8.43	12	1.5	12
SA 100	SA 100	SA 100	SA 100	2.71	11.14	2	4	8
SA 100	SA 100	SA 100	SA 100	2.42	11.14	10	3	10
SA 100	SA 100	SA 100	SA 100	2.42	11.14	12	1.5	12
SA 100	SA 100	SA 100	SA 100	2.42	11.14	14	1.5	14
SA 100	SA 100	SA 100	SA 100	2.42	11.14	16	1.5	16
SA 100	SA 100	SA 100	SA 100	2.42	11.14	166	1.5	166
SA 10								

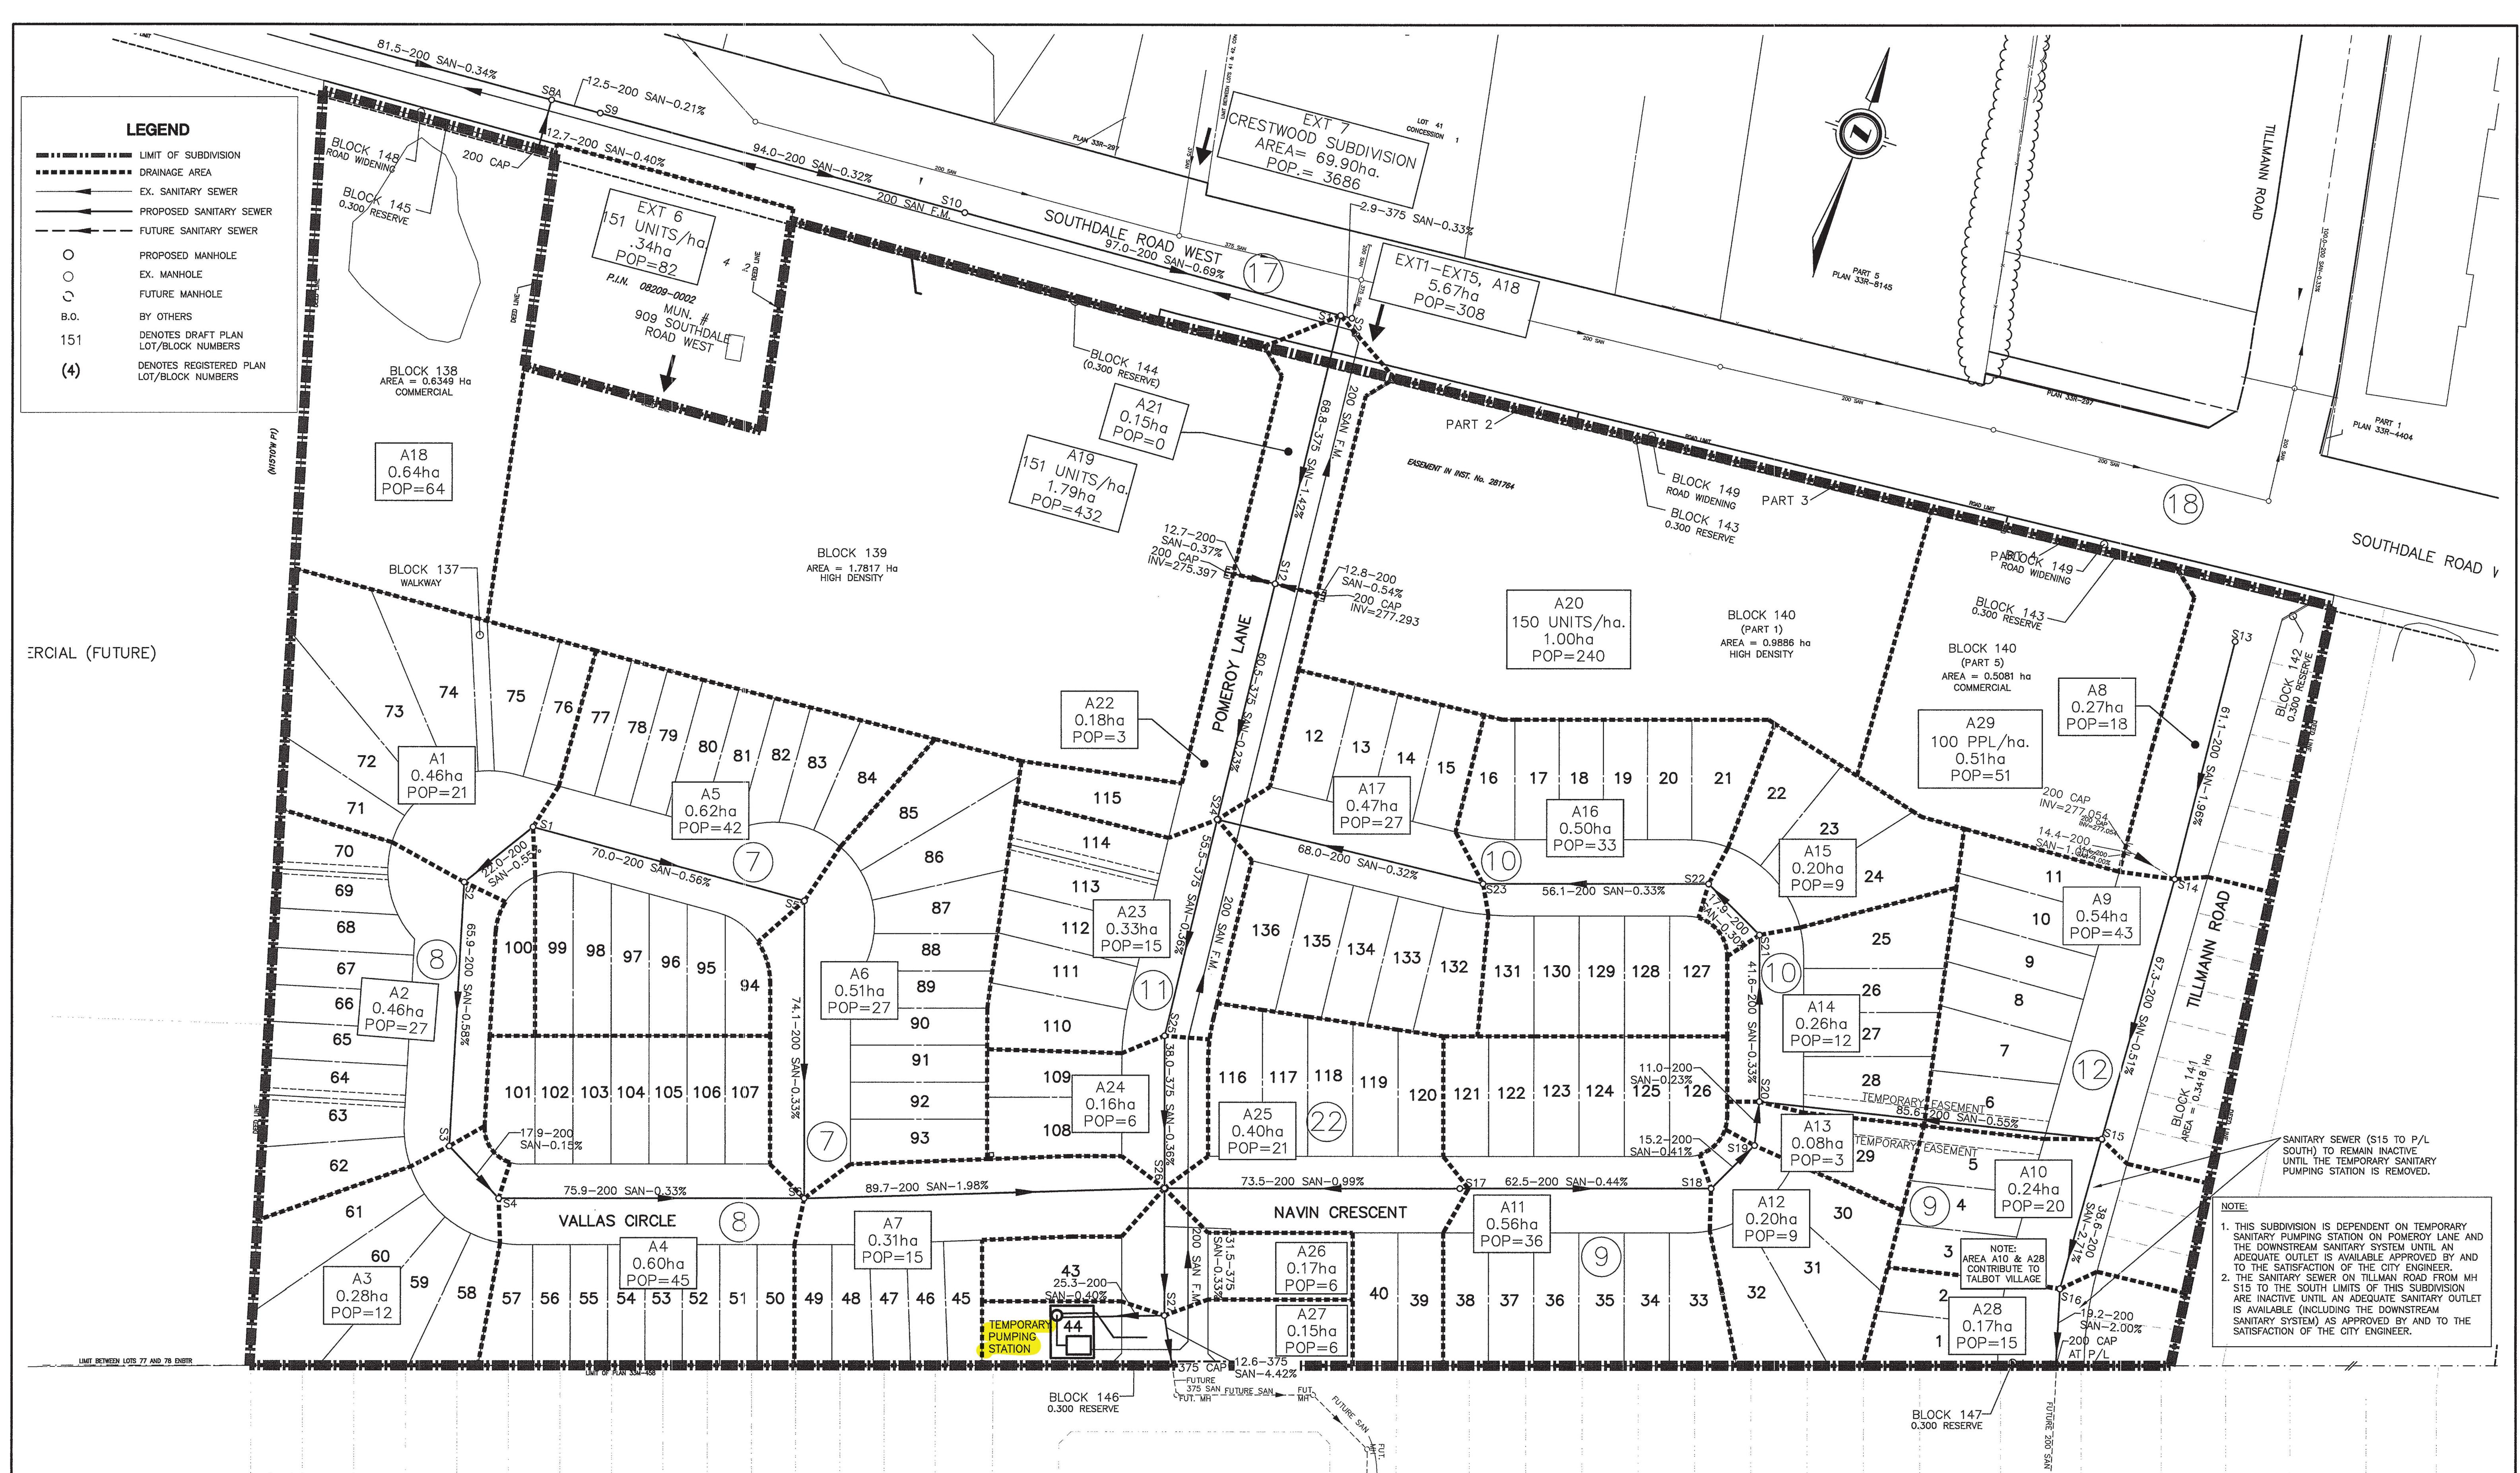

EXISTING SERVICES	DRAWING #, SOURCE	DATE	CONSTRUCTED SERVICES	COMPLETION	DETAILS	No.	REVISIONS	DATE	CONSULTANT
SAN SEWERS, PDC's & M.H.'s		JAN 2011	DESIGN	JKA		1	PER C.O.L. COMMENTS	AUG 07, 2009	JKA
STM. SEWERS, PDC's & M.H.'s		JAN 2011	DRAWN BY JKA			2	PER C.O.L. COMMENTS	OCT 27, 2009	JKA
W.M. & W.L.S.		JAN 2011	CHECKED	DWH		3	PER C.O.L. COMMENTS	NOV 26/09	JKA
GRANULAR BASE		OCT 2011	APPROVED DWH			4	REVISED BLOCK 140	NOV 3/2010	DJL
CURBS & GUTTERS		OCT 2011	DATE NOV 2008			5	PER C.O.L. COMMENTS	DEC 3/2010	DJL
PAVING - I BASE		OCT 2011				6	AS-CONSTRUCTED	SEPT 13	PS
II SURFACE									

161403231San.dwg

PROJECT No.	33M-621
HEET No.	3 of 29
PLAN FILE No.	24382
TITLE	WESTFIELD VILLAGE ESTATES YORK DEVELOPMENTS
SCALE HORZ:	1:750
INTERIM SANITARY DRAINAGE AREA PLAN	

Stantec Consulting Ltd.
171 Queens Avenue, 8th Floor
London ON Canada N6A 5J7
Phone: (519) 645-2007
Fax: (519) 645-6575
E-mail: london@stantec.com

LICENSED PROFESSIONAL ENGINEER
Oct 25/13
D.W. HERN
100077071
PROVINCE OF ONTARIO

CORPORATION OF THE
CITY OF LONDON

London
CANADA

Kurtis Caron

From: Winters, Devin <dwinters@london.ca>
Sent: February 15, 2022 10:59 AM
To: Kurtis Caron
Subject: RE: SBM-22-0021 York Developments - 415 Boler Road - Sanitary Design Sheet Request

Hi Kurtis,

I confirmed with our stormwater division that this pumping station is no longer operational.

Regards,



Devin Winters
Technologist I
Geomatics Division
City of London

300 Dufferin Ave., P.O. Box 5035, London ON, N6A 4L9
P: 519.661.2489 x 2337 | Fax: 519.661.6422
dwinters@london.ca | www.london.ca


From: Kurtis Caron <kcaron@sbmltd.ca>
Sent: Tuesday, February 15, 2022 8:47 AM
To: Winters, Devin <dwinters@london.ca>
Subject: [EXTERNAL] RE: SBM-22-0021 York Developments - 415 Boler Road - Sanitary Design Sheet Request


Hi Devin,


I'm working on analyzing the sanitary network connected to Boler Road and there appears to be a "temporary sanitary pumping station" which seems to have formerly serviced a portion of the Westfield Village Estates subdivision.

I've included some images below from the locates website indicating the alignment of the sanitary sewer which shows it connecting the subdivision to Boler Road. It appears to me that the pumping station is no longer operational as flows from that phase of the subdivision, will now connect to the southern portion of the Westfield Village Estates subdivision, and then will be pumped to the 350mm forcemain which runs North on Colonel Talbot Road.

Can you please confirm that the temporary pumping station as shown on the attached record drawing 24382 is no longer operational? I would assume if that is the case, the associated 200mm sanitary force main connecting the Westfield Village Estates subdivision to Boler road would also no longer be operational.

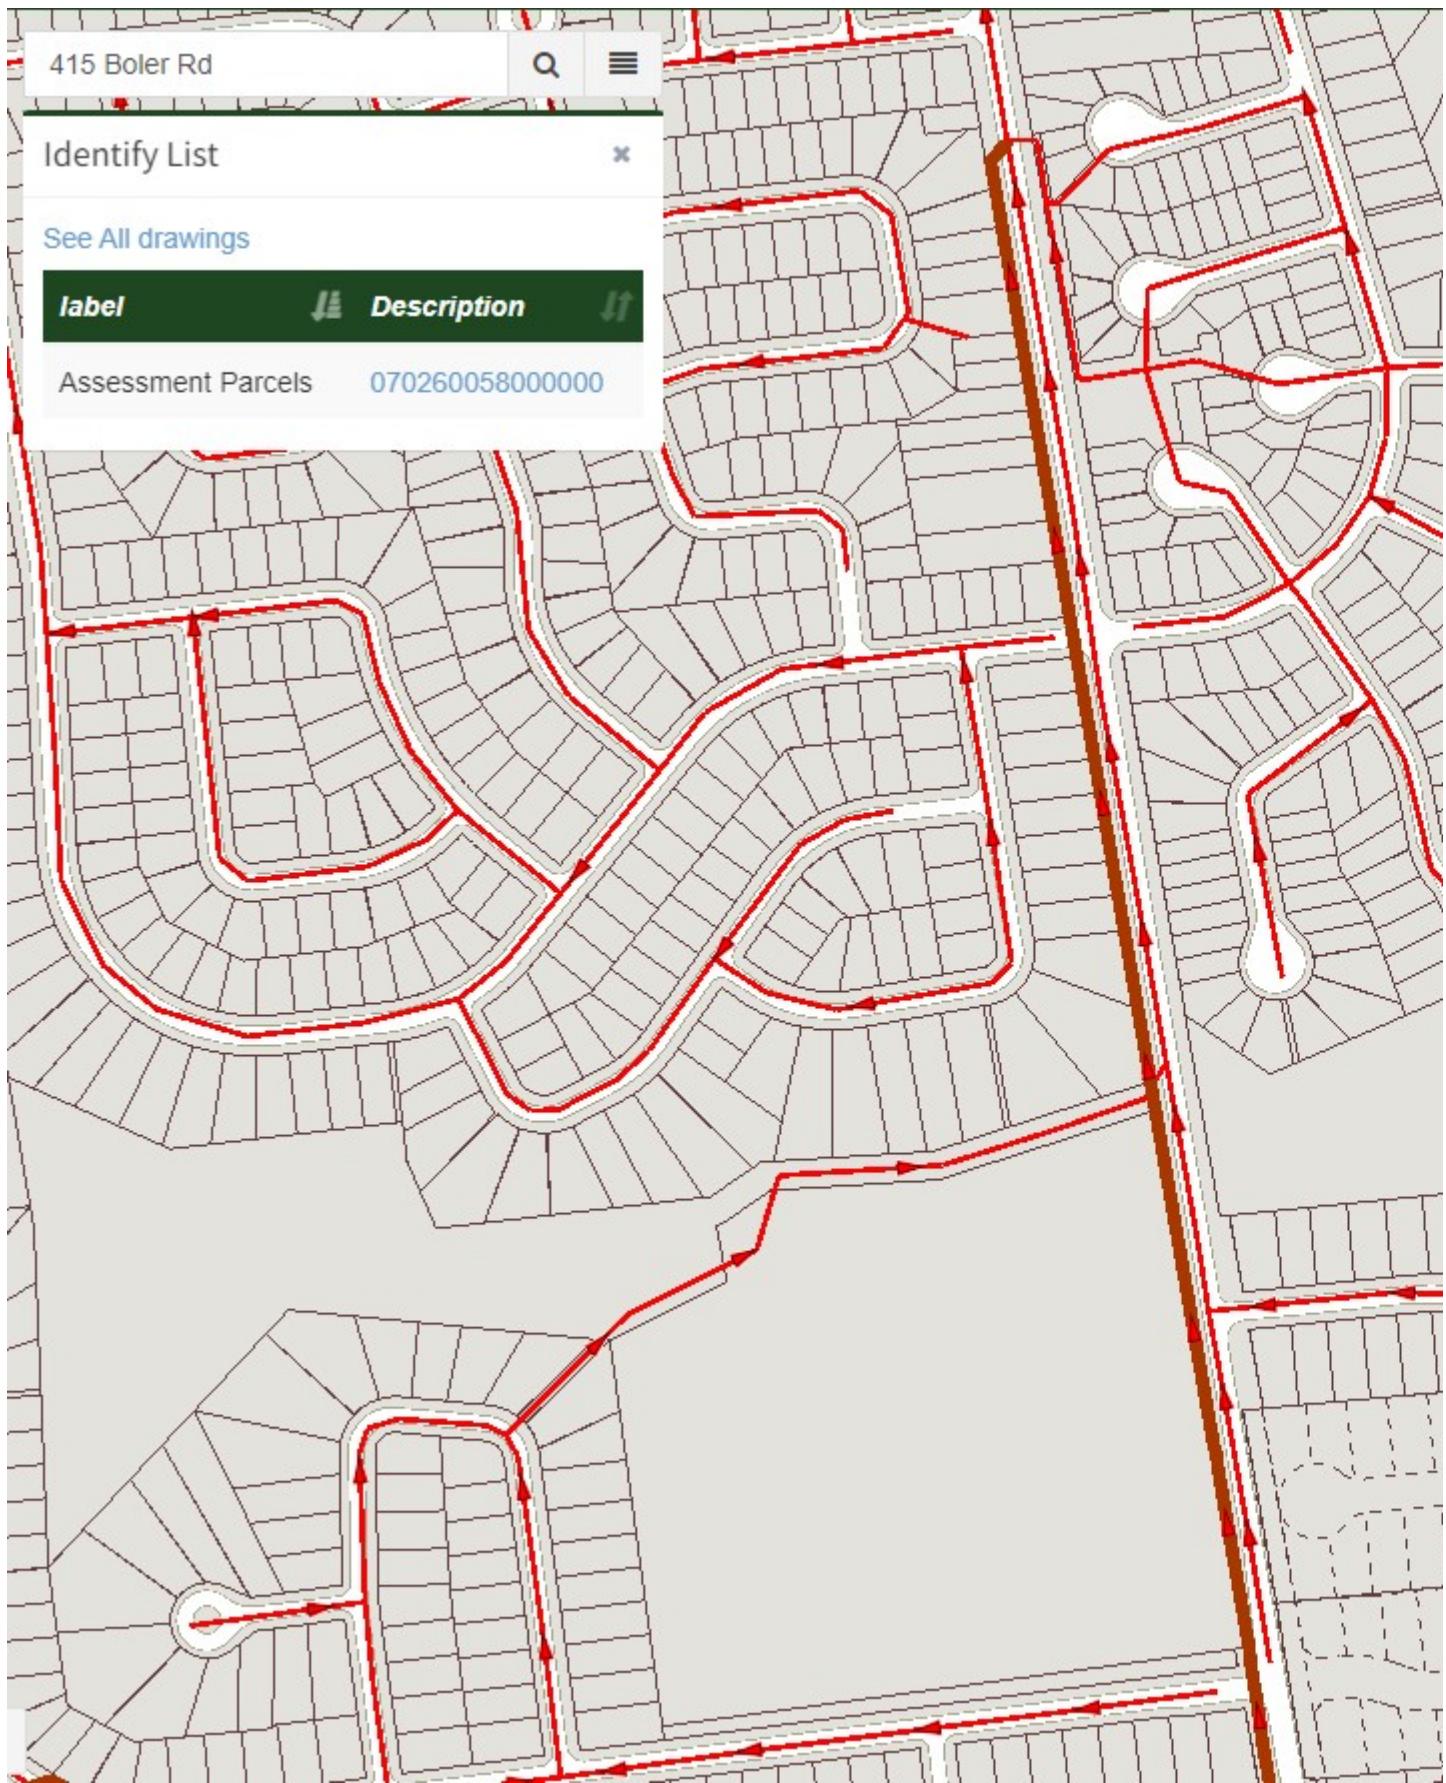

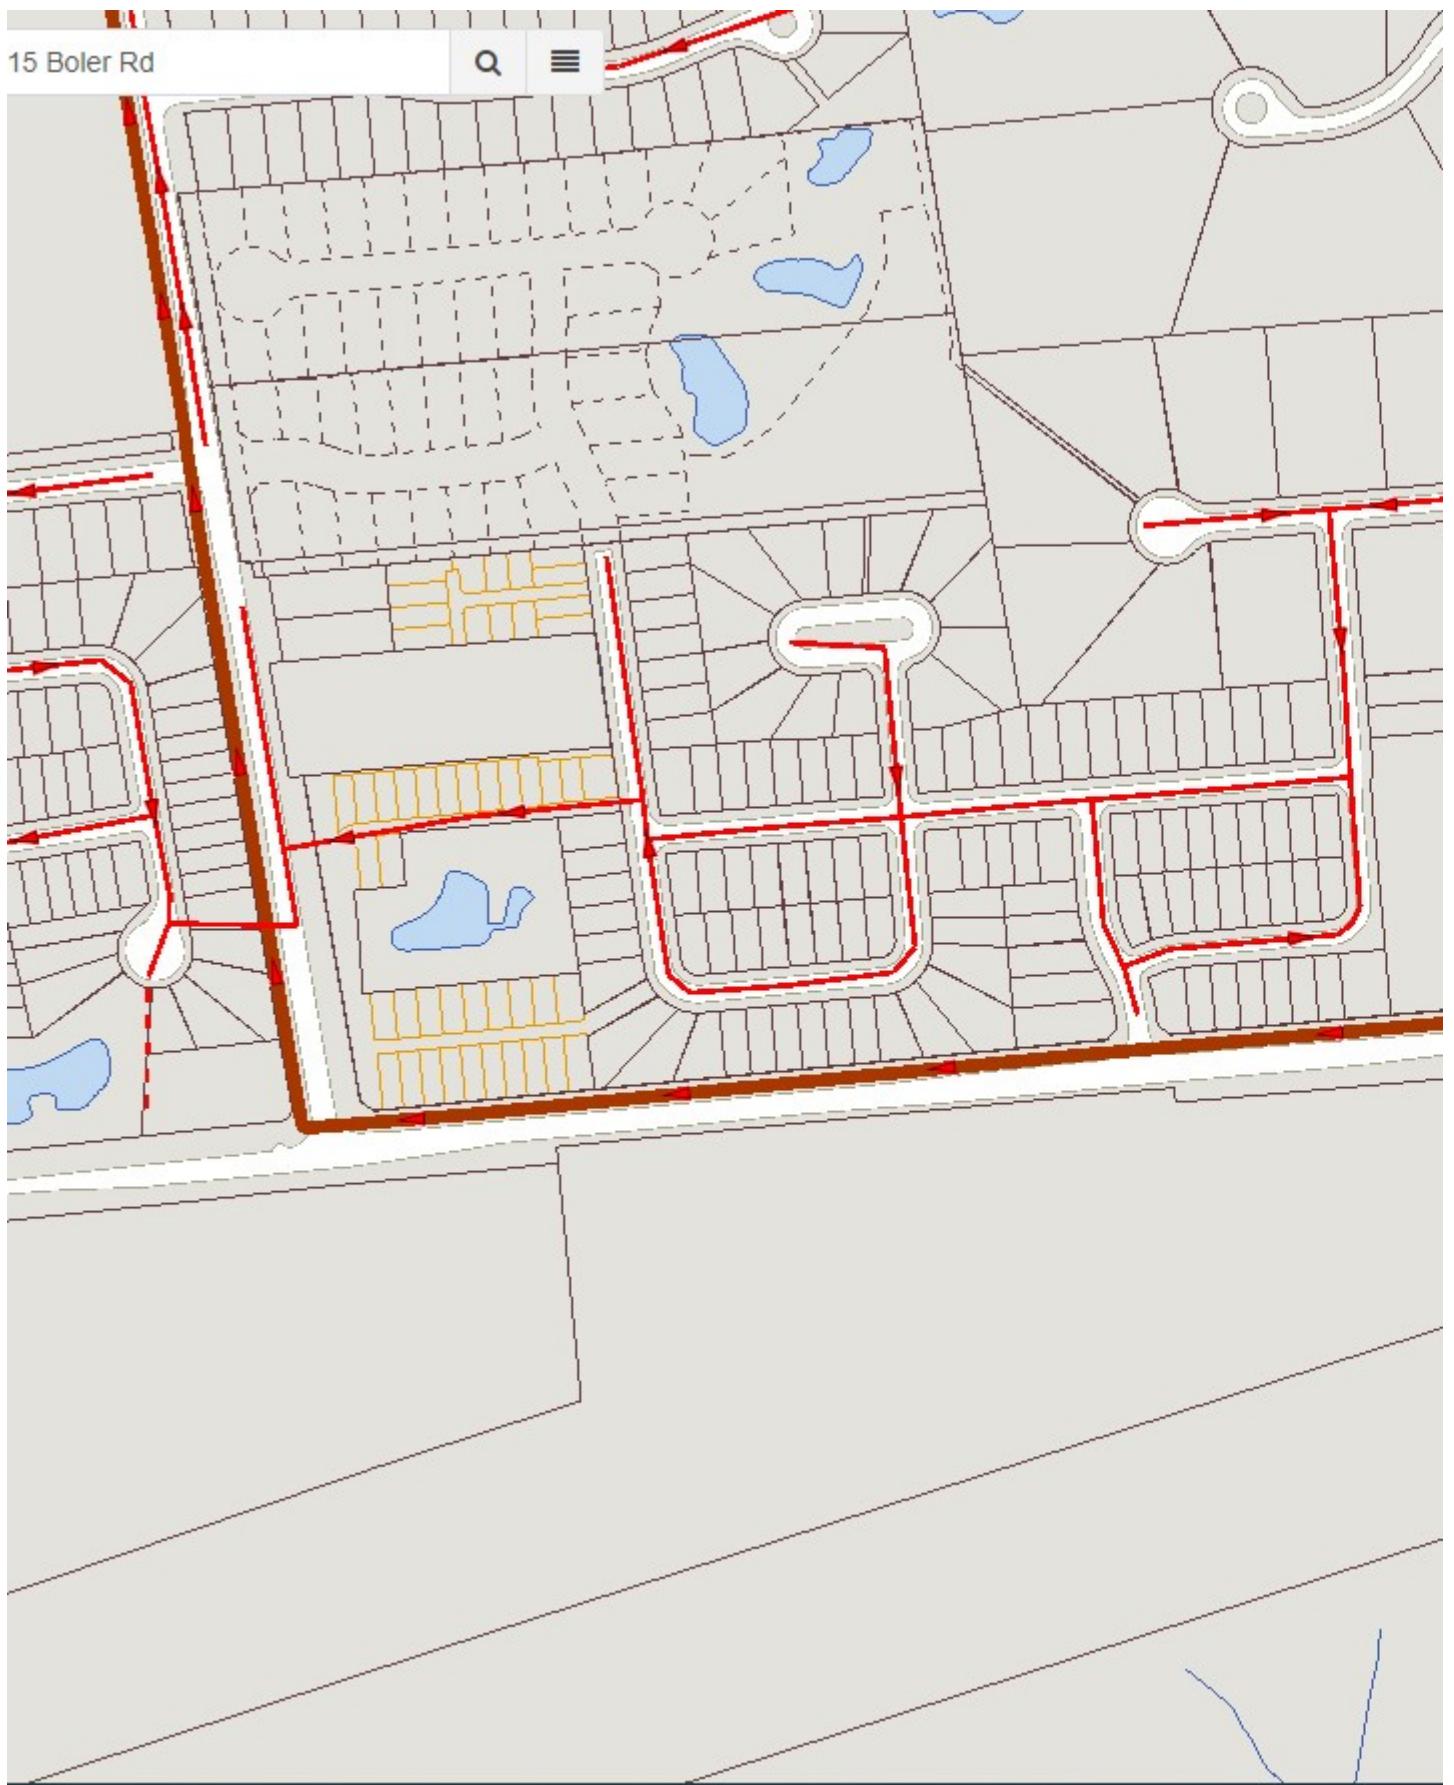

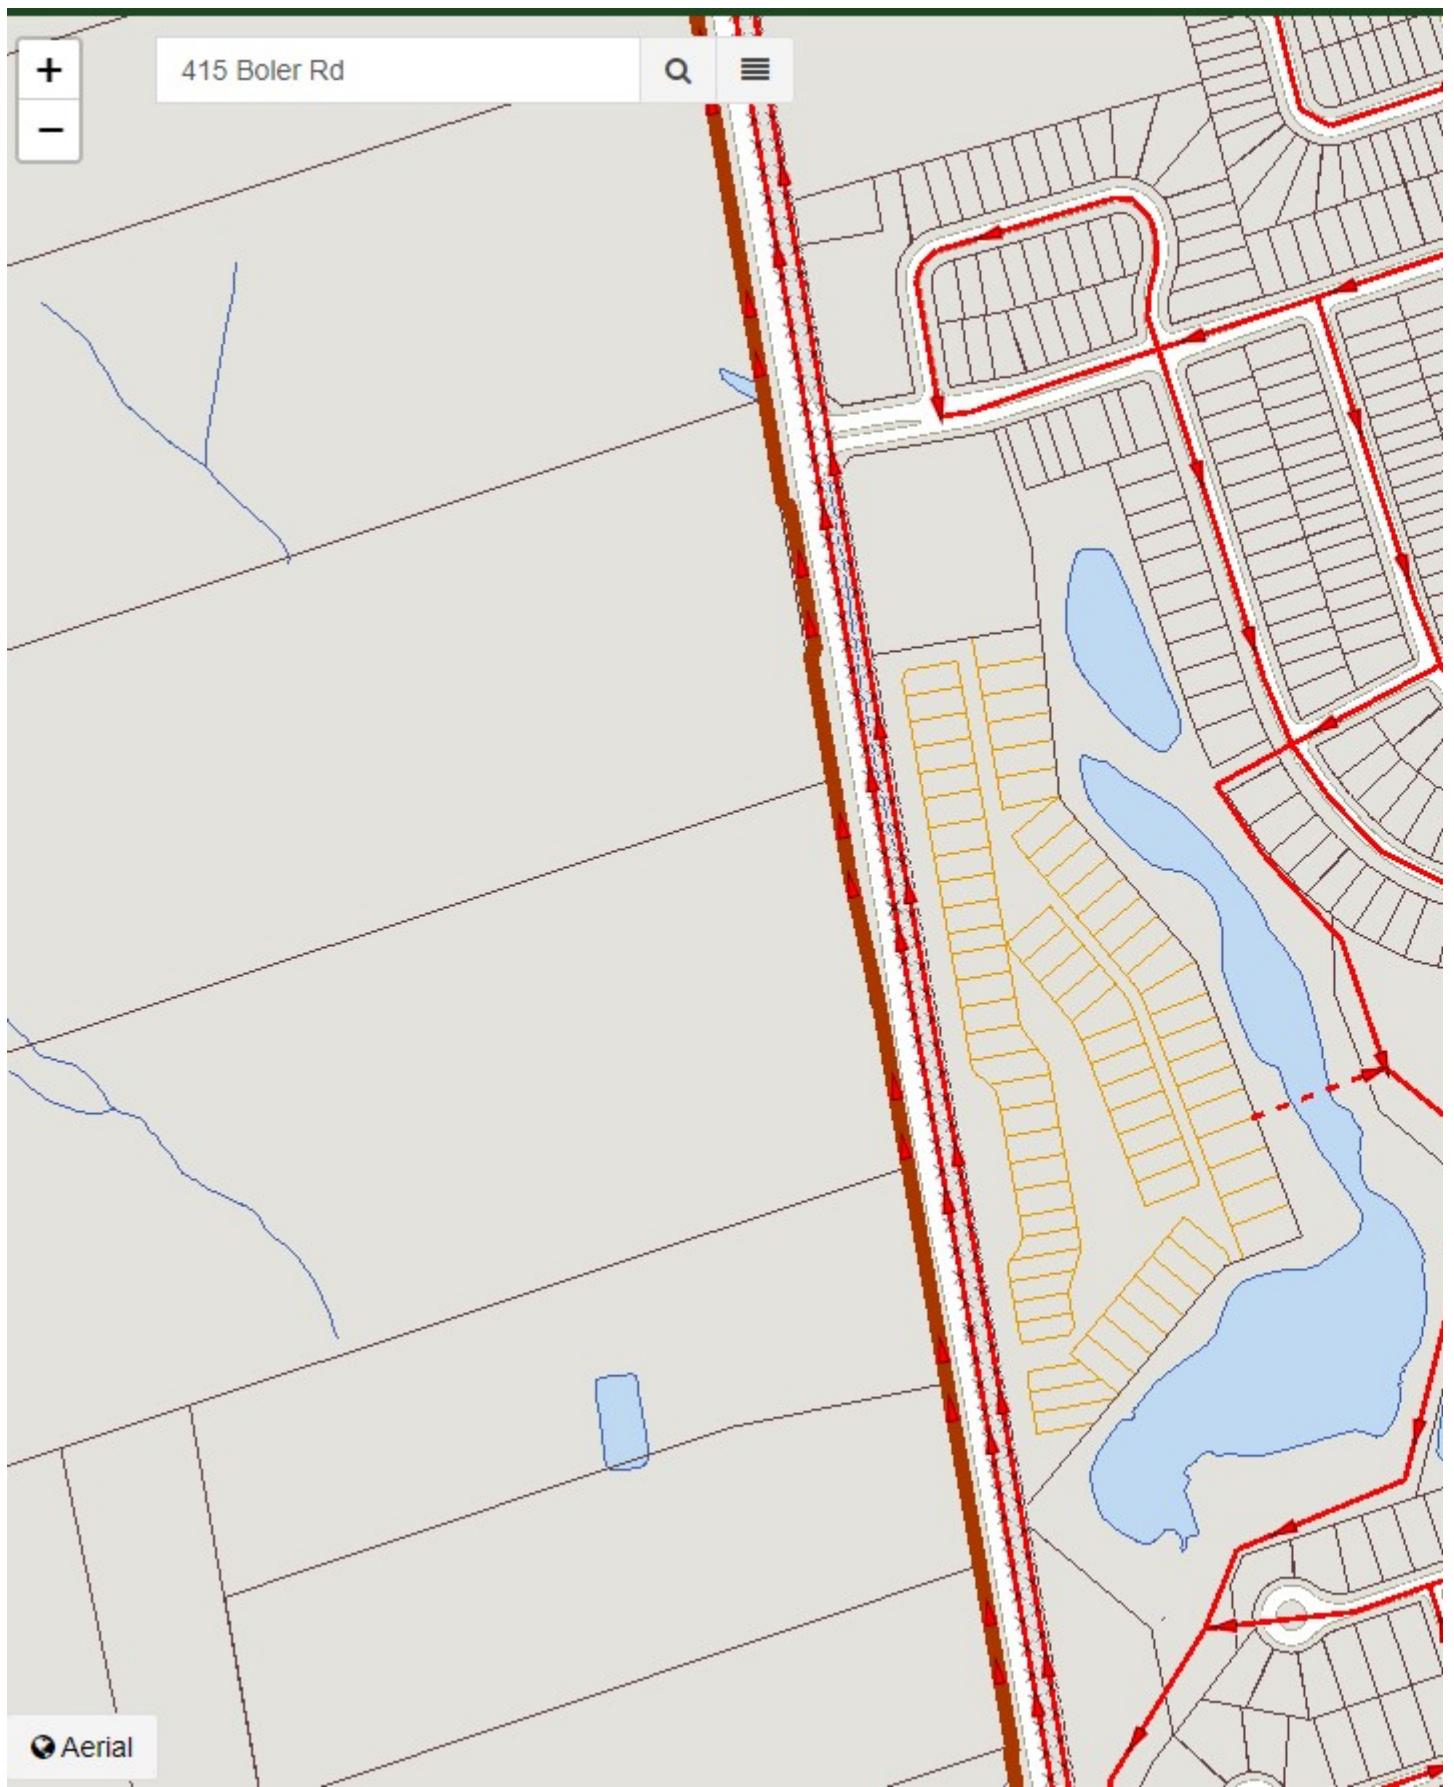

Please feel free to give me a call at 905 988 0057 to discuss if needed.

Thanks,

Kurtis Caron

Civil EIT II

P: 519-725-8093 x416

C: 905-988-0057


E: kcaron@sbmltd.ca





PLANNING • CIVIL • STRUCTURAL • MECHANICAL • ELECTRICAL




Study Catchment Area Limits

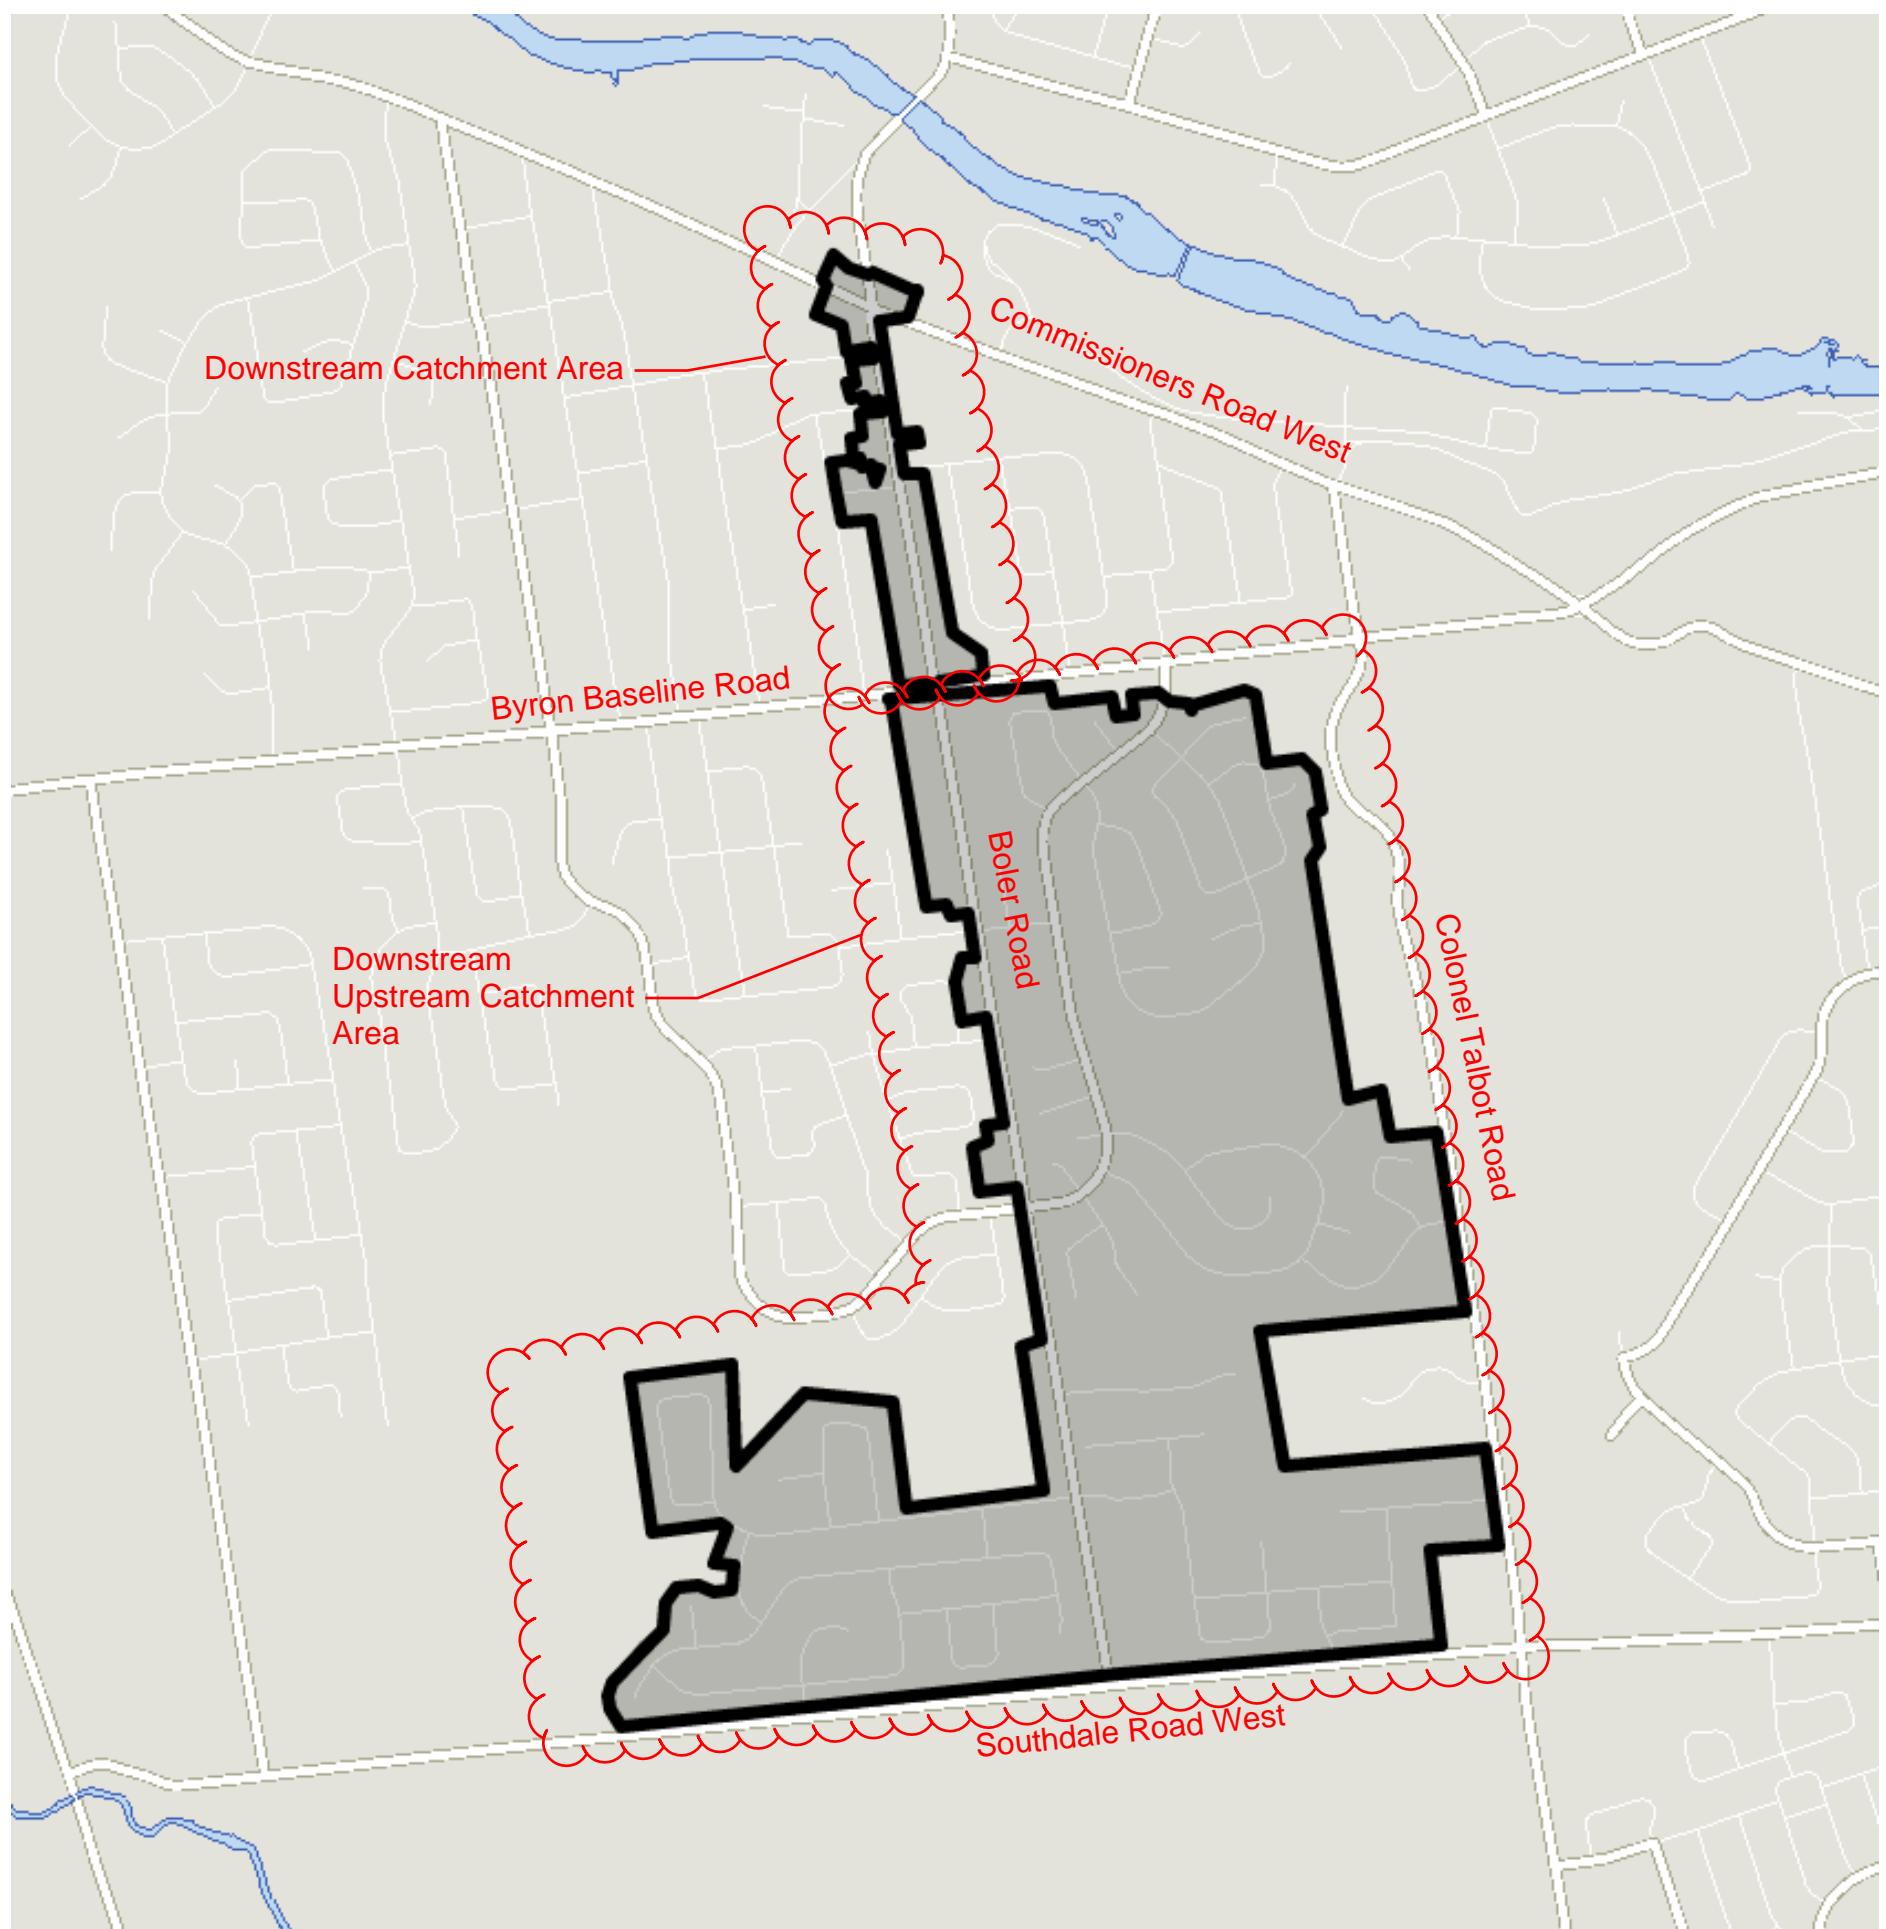


Downstream Area: City of London Mapping Markup

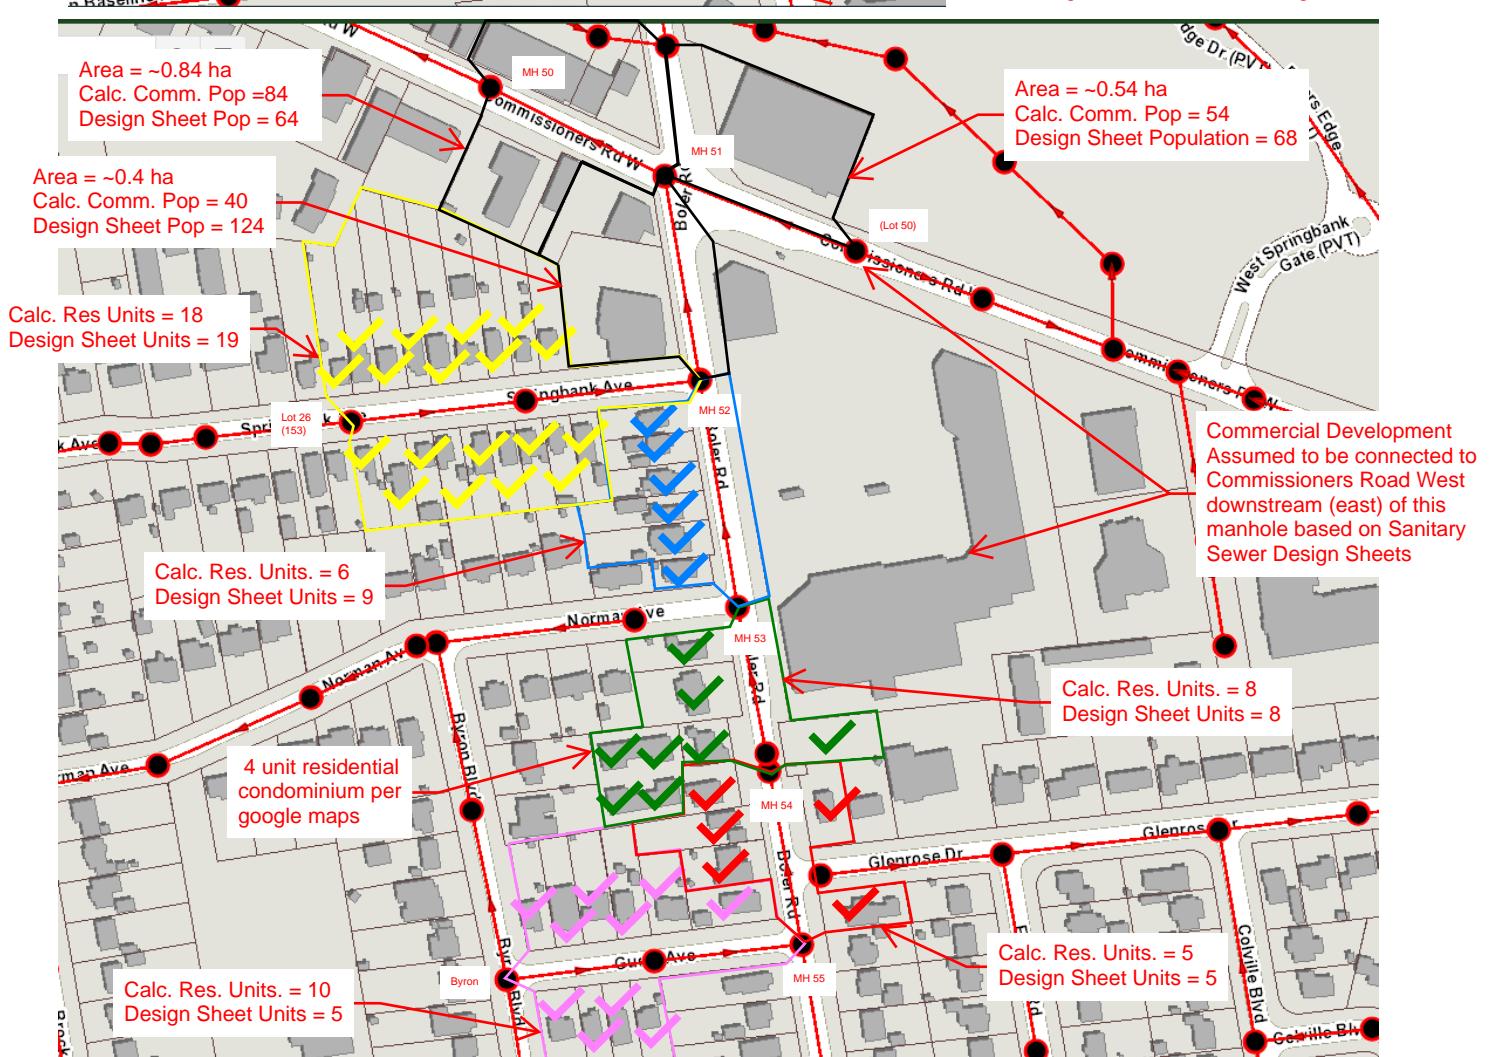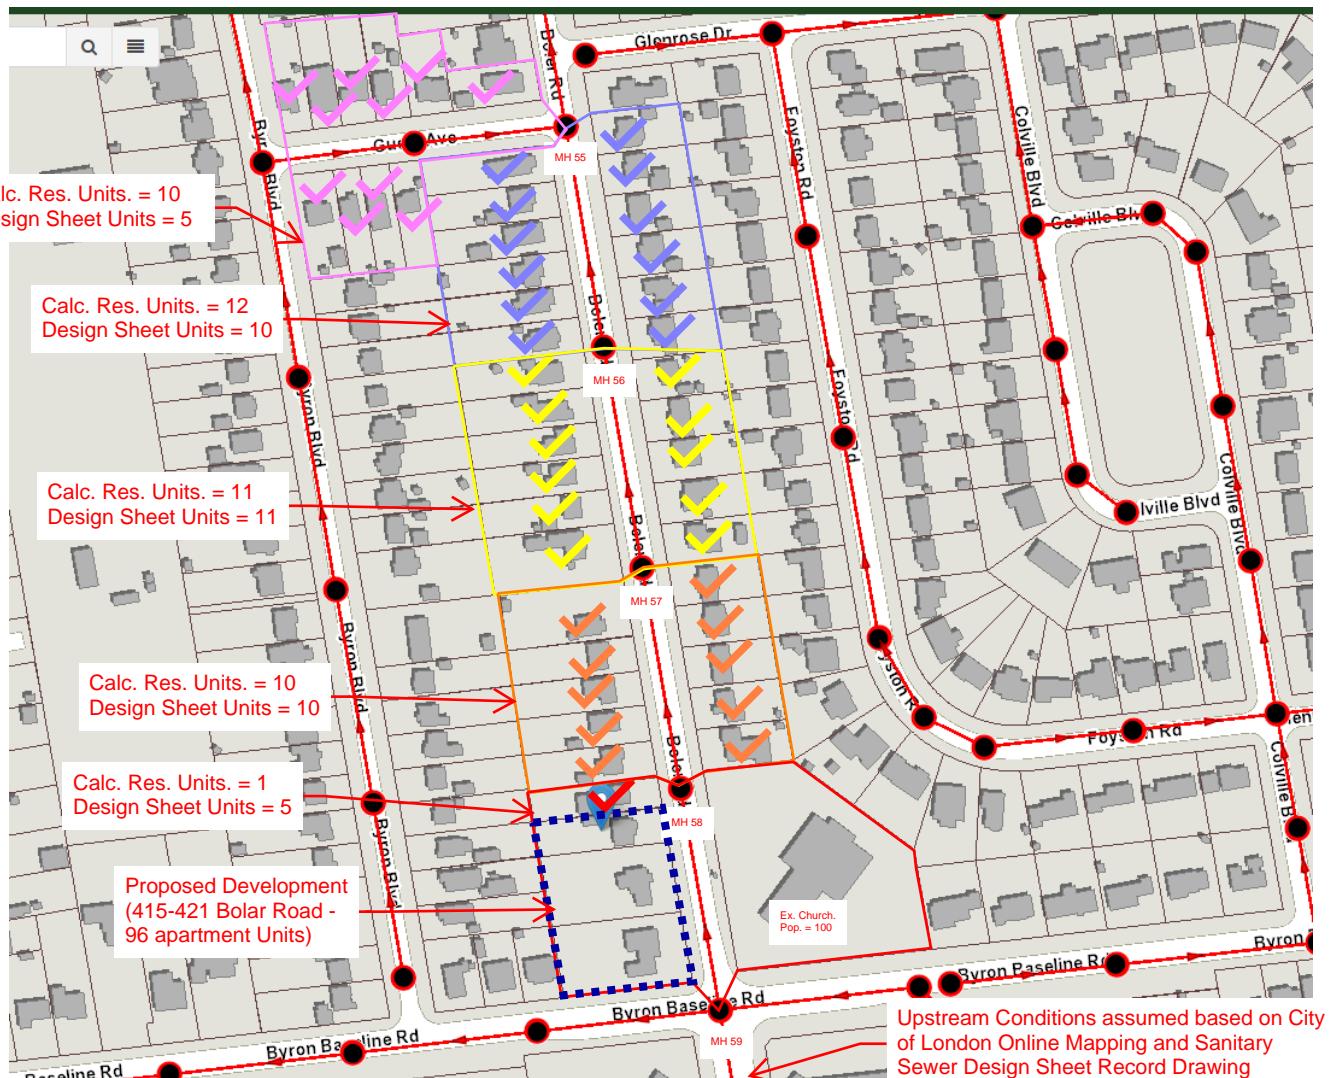

Upstream Sanitary Catchment Area

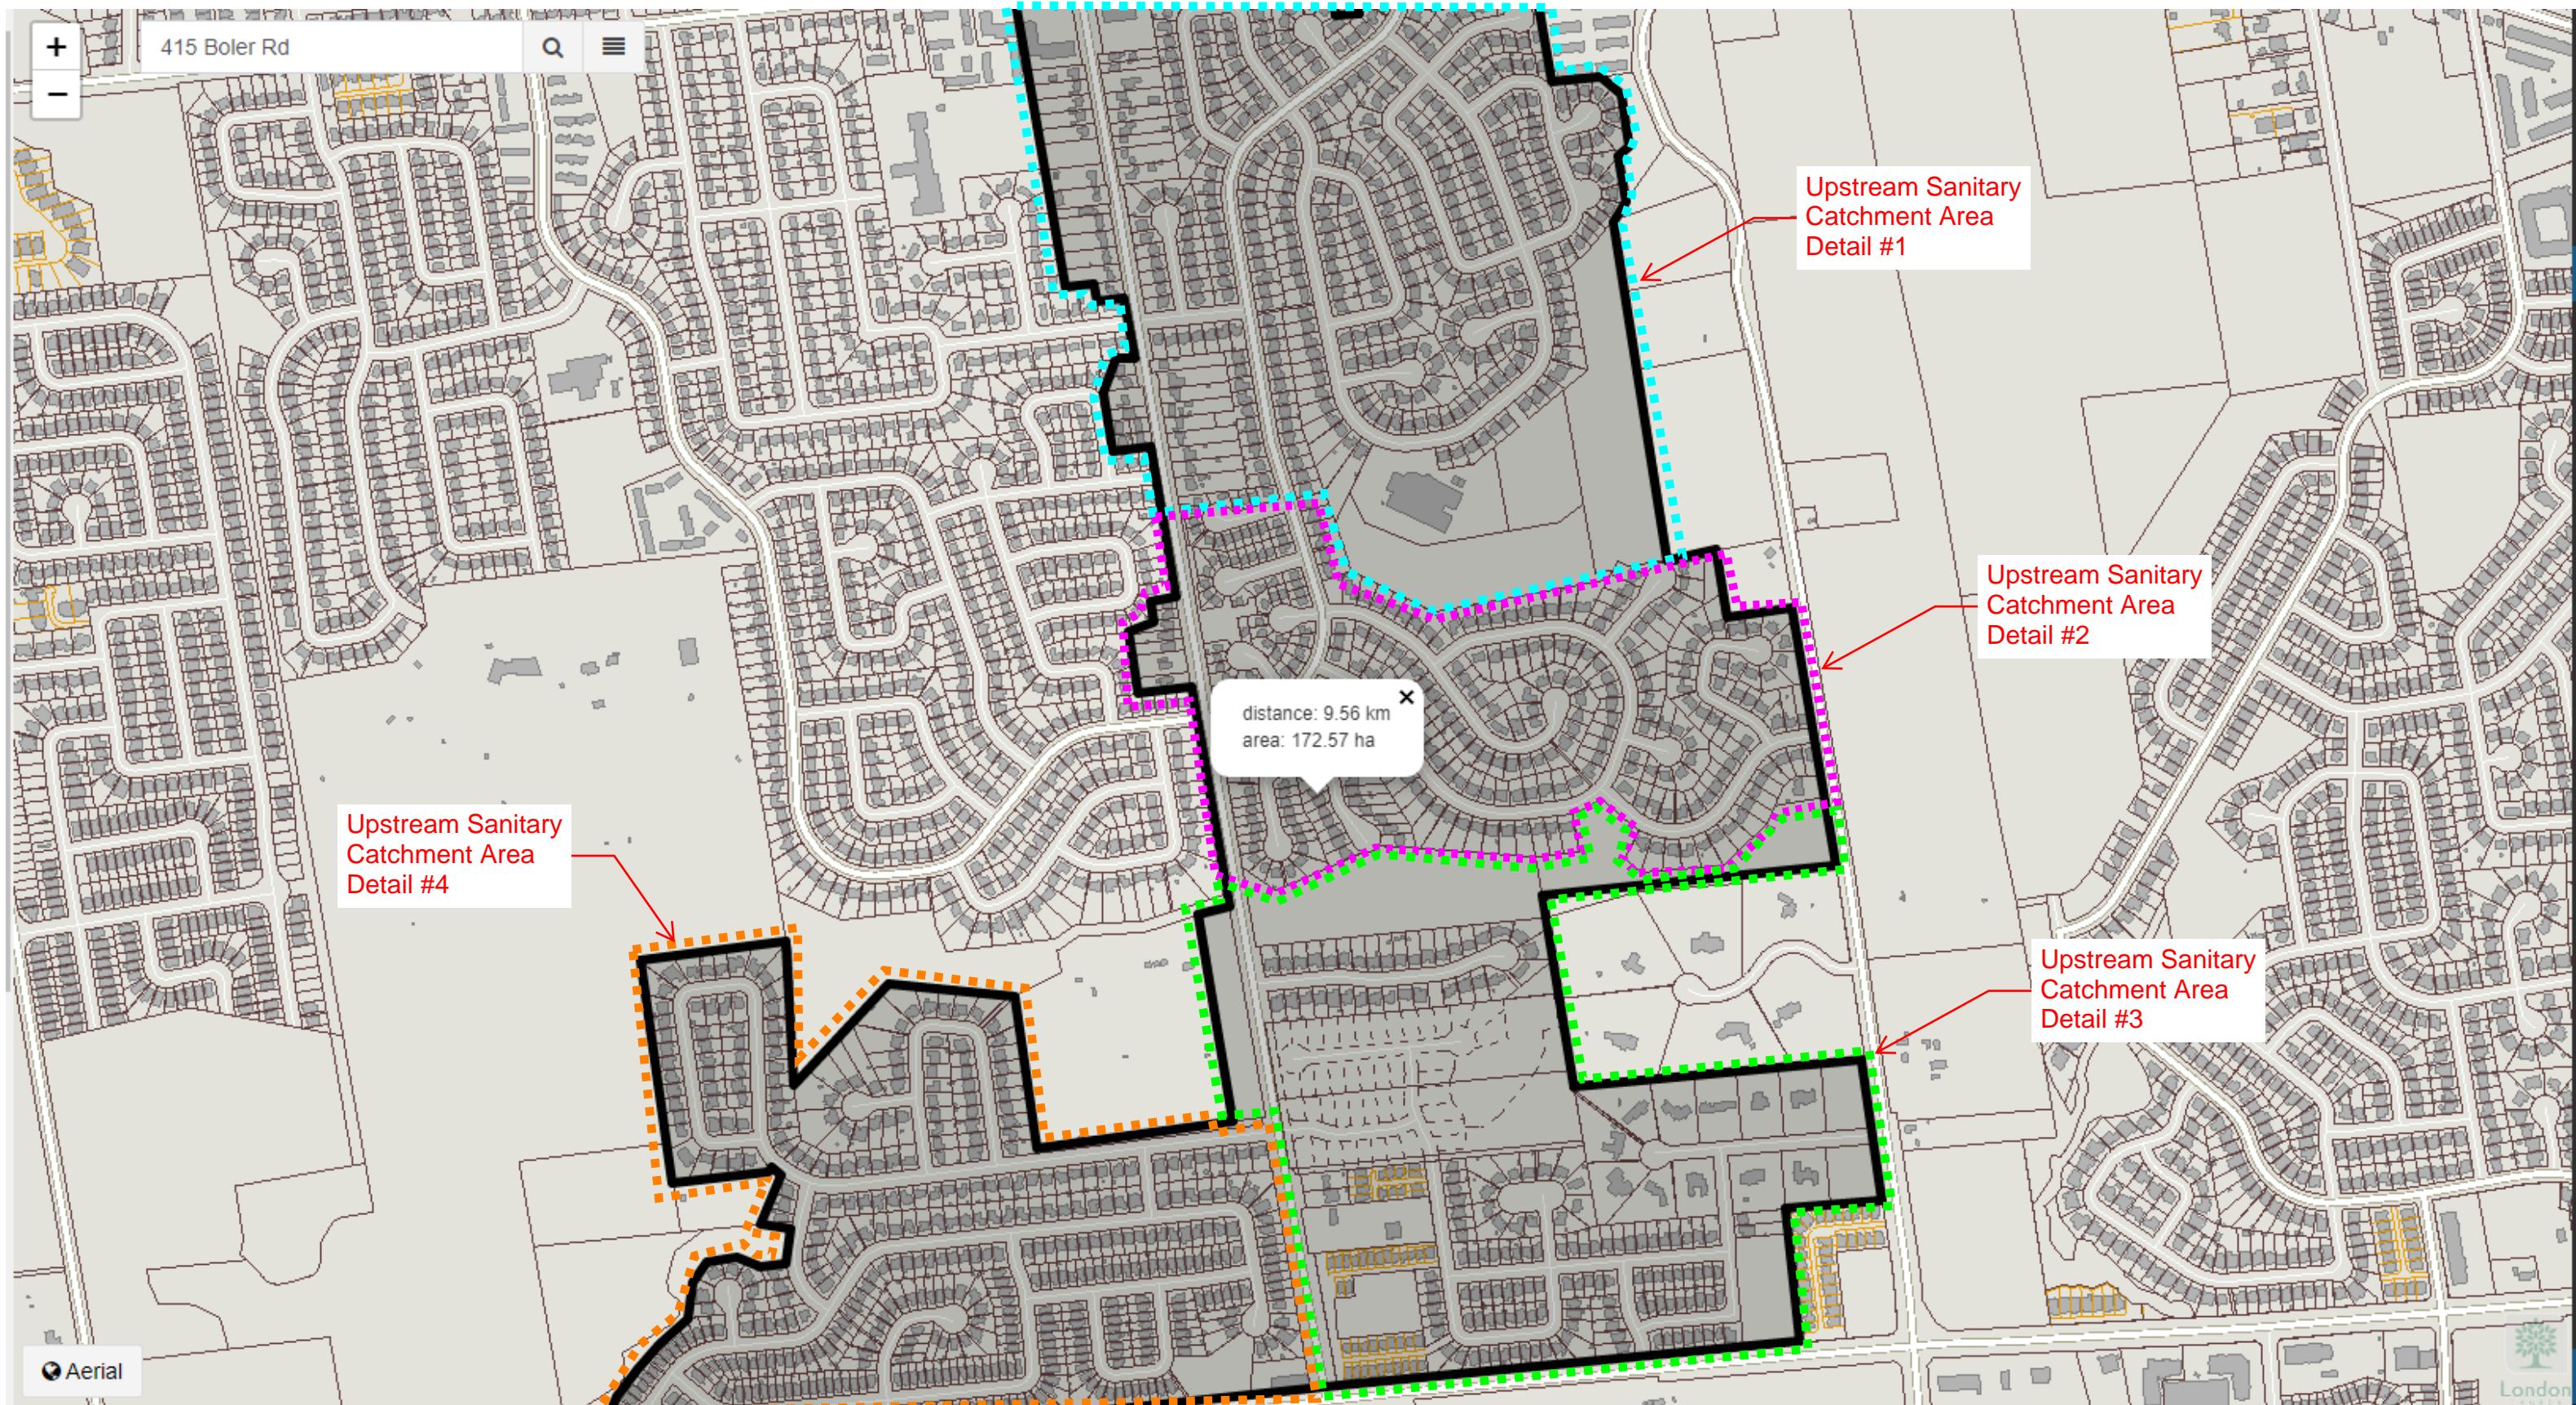

Upstream Sanitary Catchment Area Detail #1

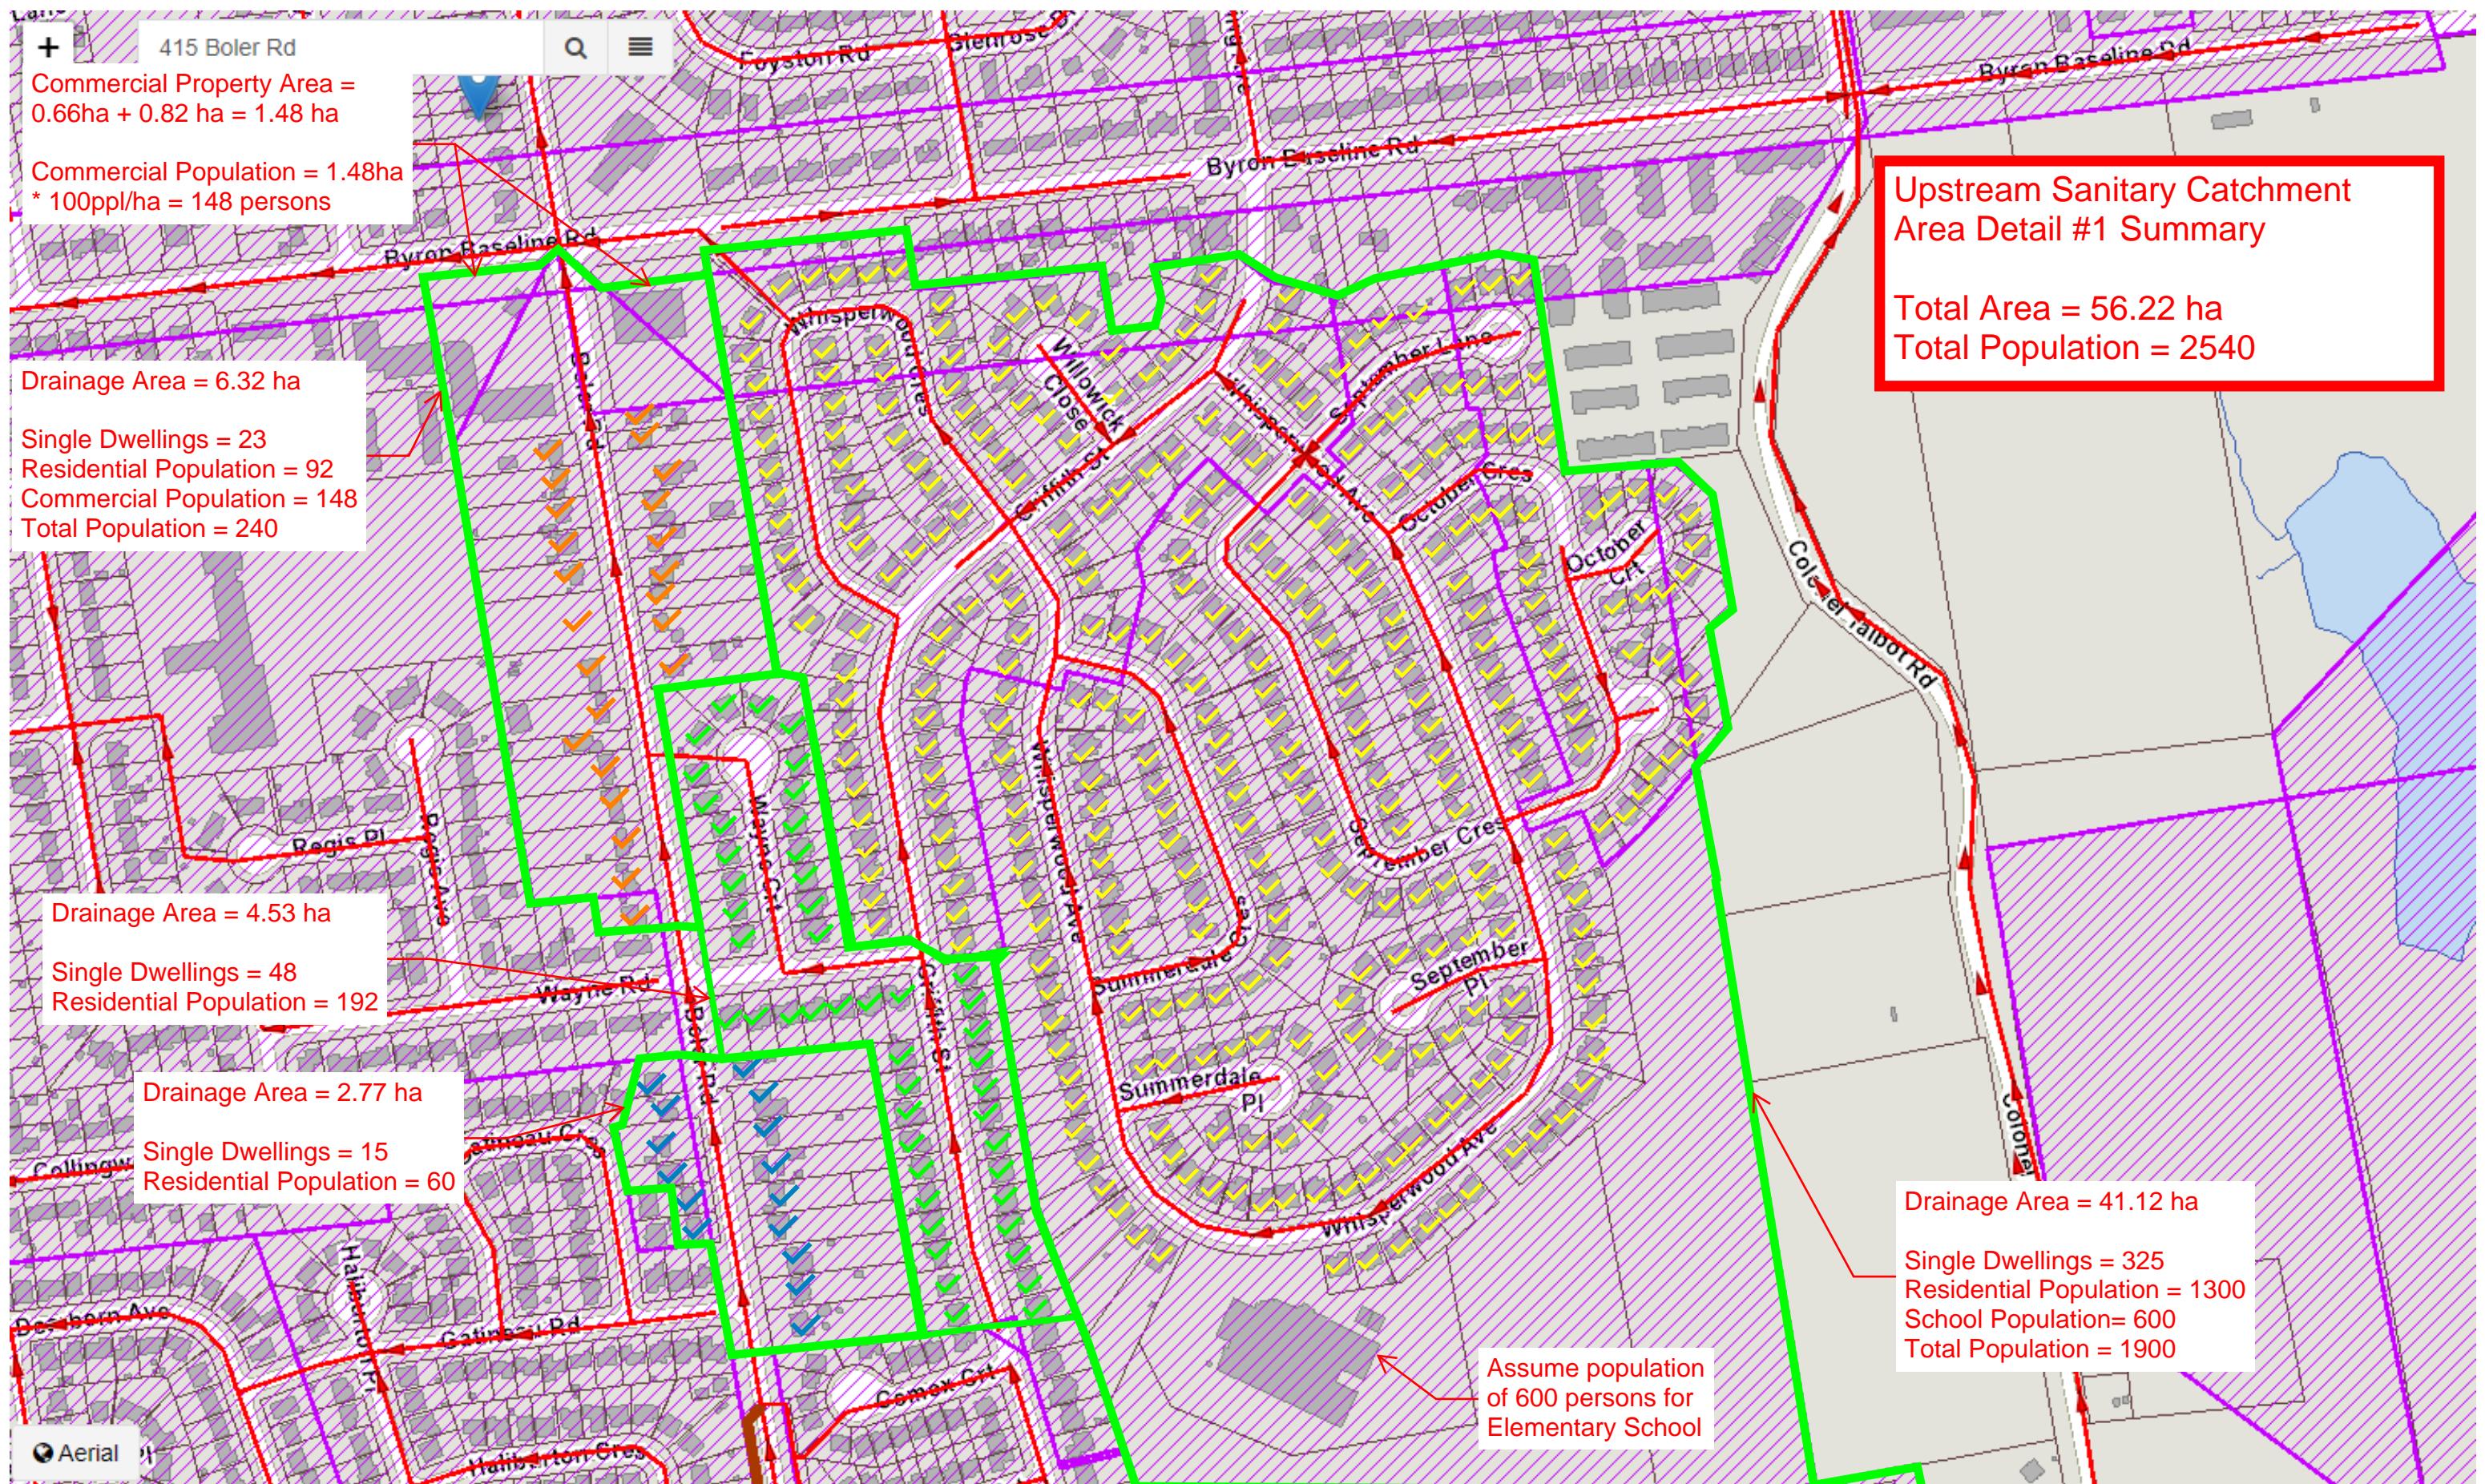


- Residential populations assumed 4 people/unit per "Low Density Residential" Density noted on Record Drawings 5415 and 5420 (Sanitary Area and Sanitary Design Sheets)

- Elementary school population per DS&RM section 3.8.1

- Commercial area population density per DS&RM 3.8.1

- Background image sourced from City of London Locates

Upstream Sanitary Catchment Area Detail #2

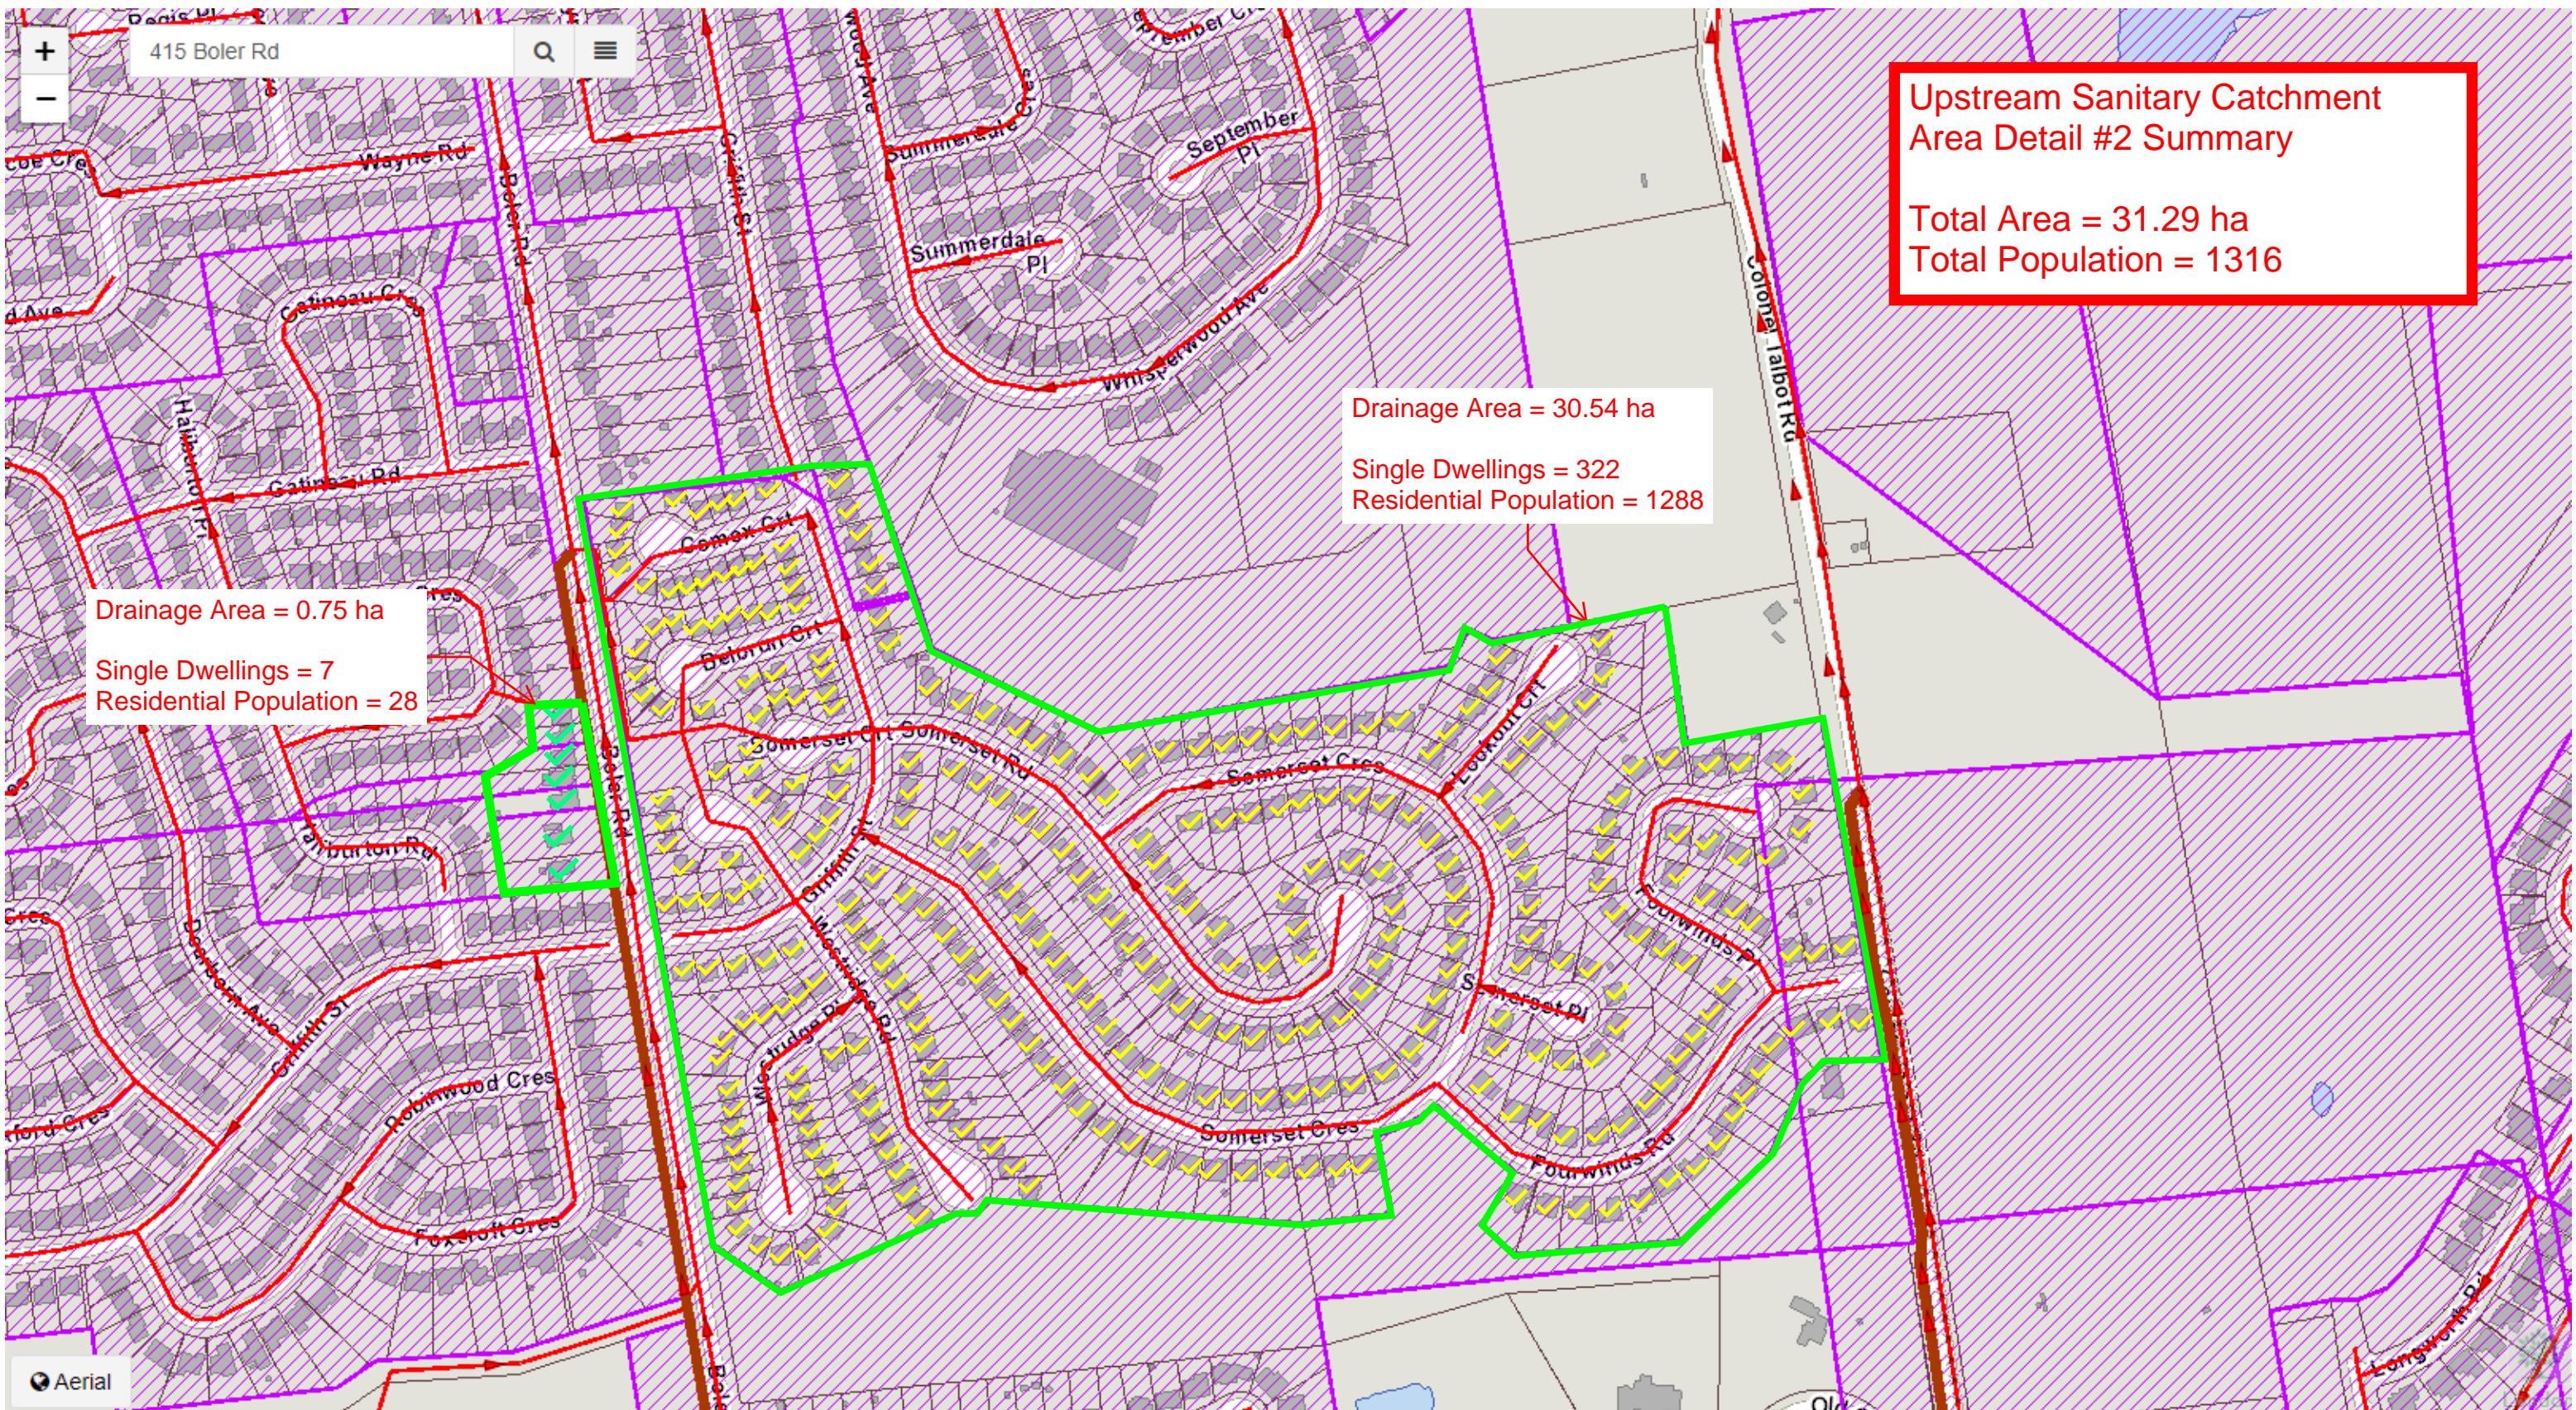


- Residential populations assumed 4 people/unit per "Low Density Residential" Density noted on Record Drawings 5415 and 5420 (Sanitary Area and Sanitary Design Sheets)

- Elementary school population per DS&RM section 3.8.1

- Commercial area population density per DS&RM 3.8.1

- Background image sourced from City of London Locates Map (<https://maps.london.ca/LocatesMap/LocatesMap/Map#>)

Upstream Sanitary Catchment Area Detail #3

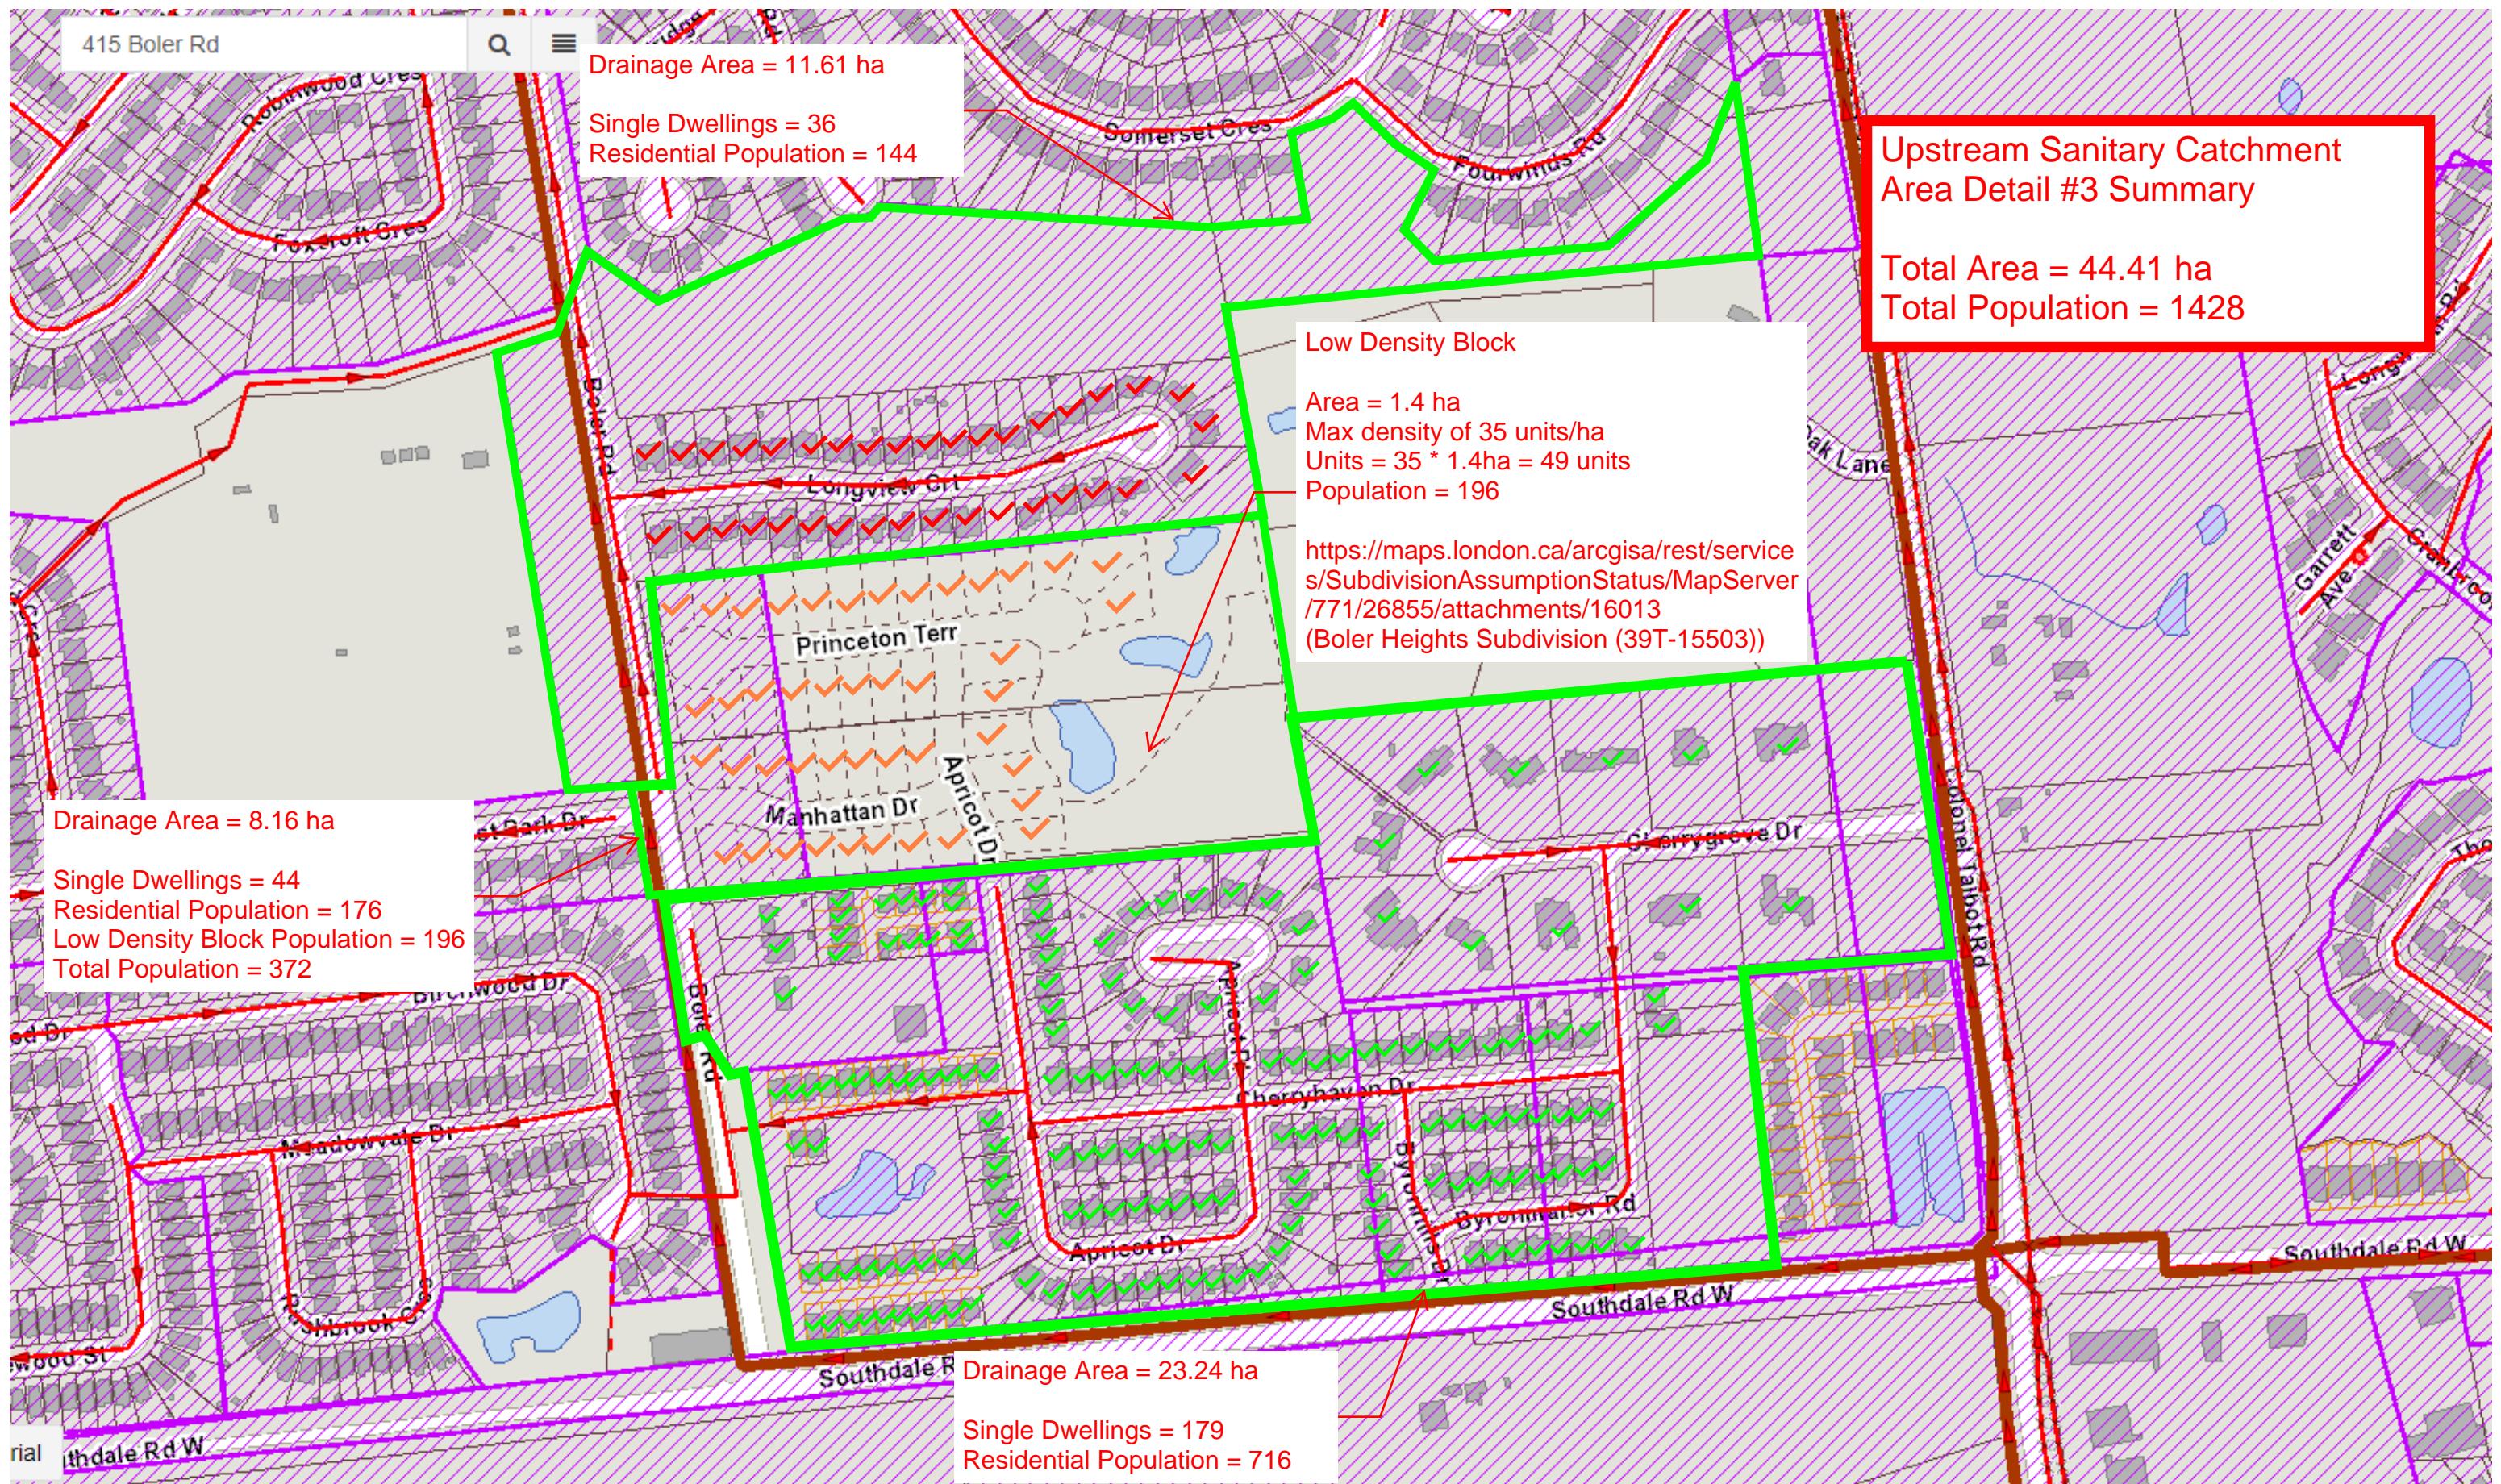


- Residential populations assumed 4 people/unit per "Low Density Residential" Density noted on Record Drawings 5415 and 5420 (Sanitary Area and Sanitary Design Sheets)

- Elementary school population per DS&RM section 3.8.1


- Commercial area population density per DS&RM 3.8.1

- Background image sourced from City of London Locates Map (<https://maps.london.ca/LocatesMap/LocatesMap/Map#>)

Upstream Sanitary Catchment Area Detail #4

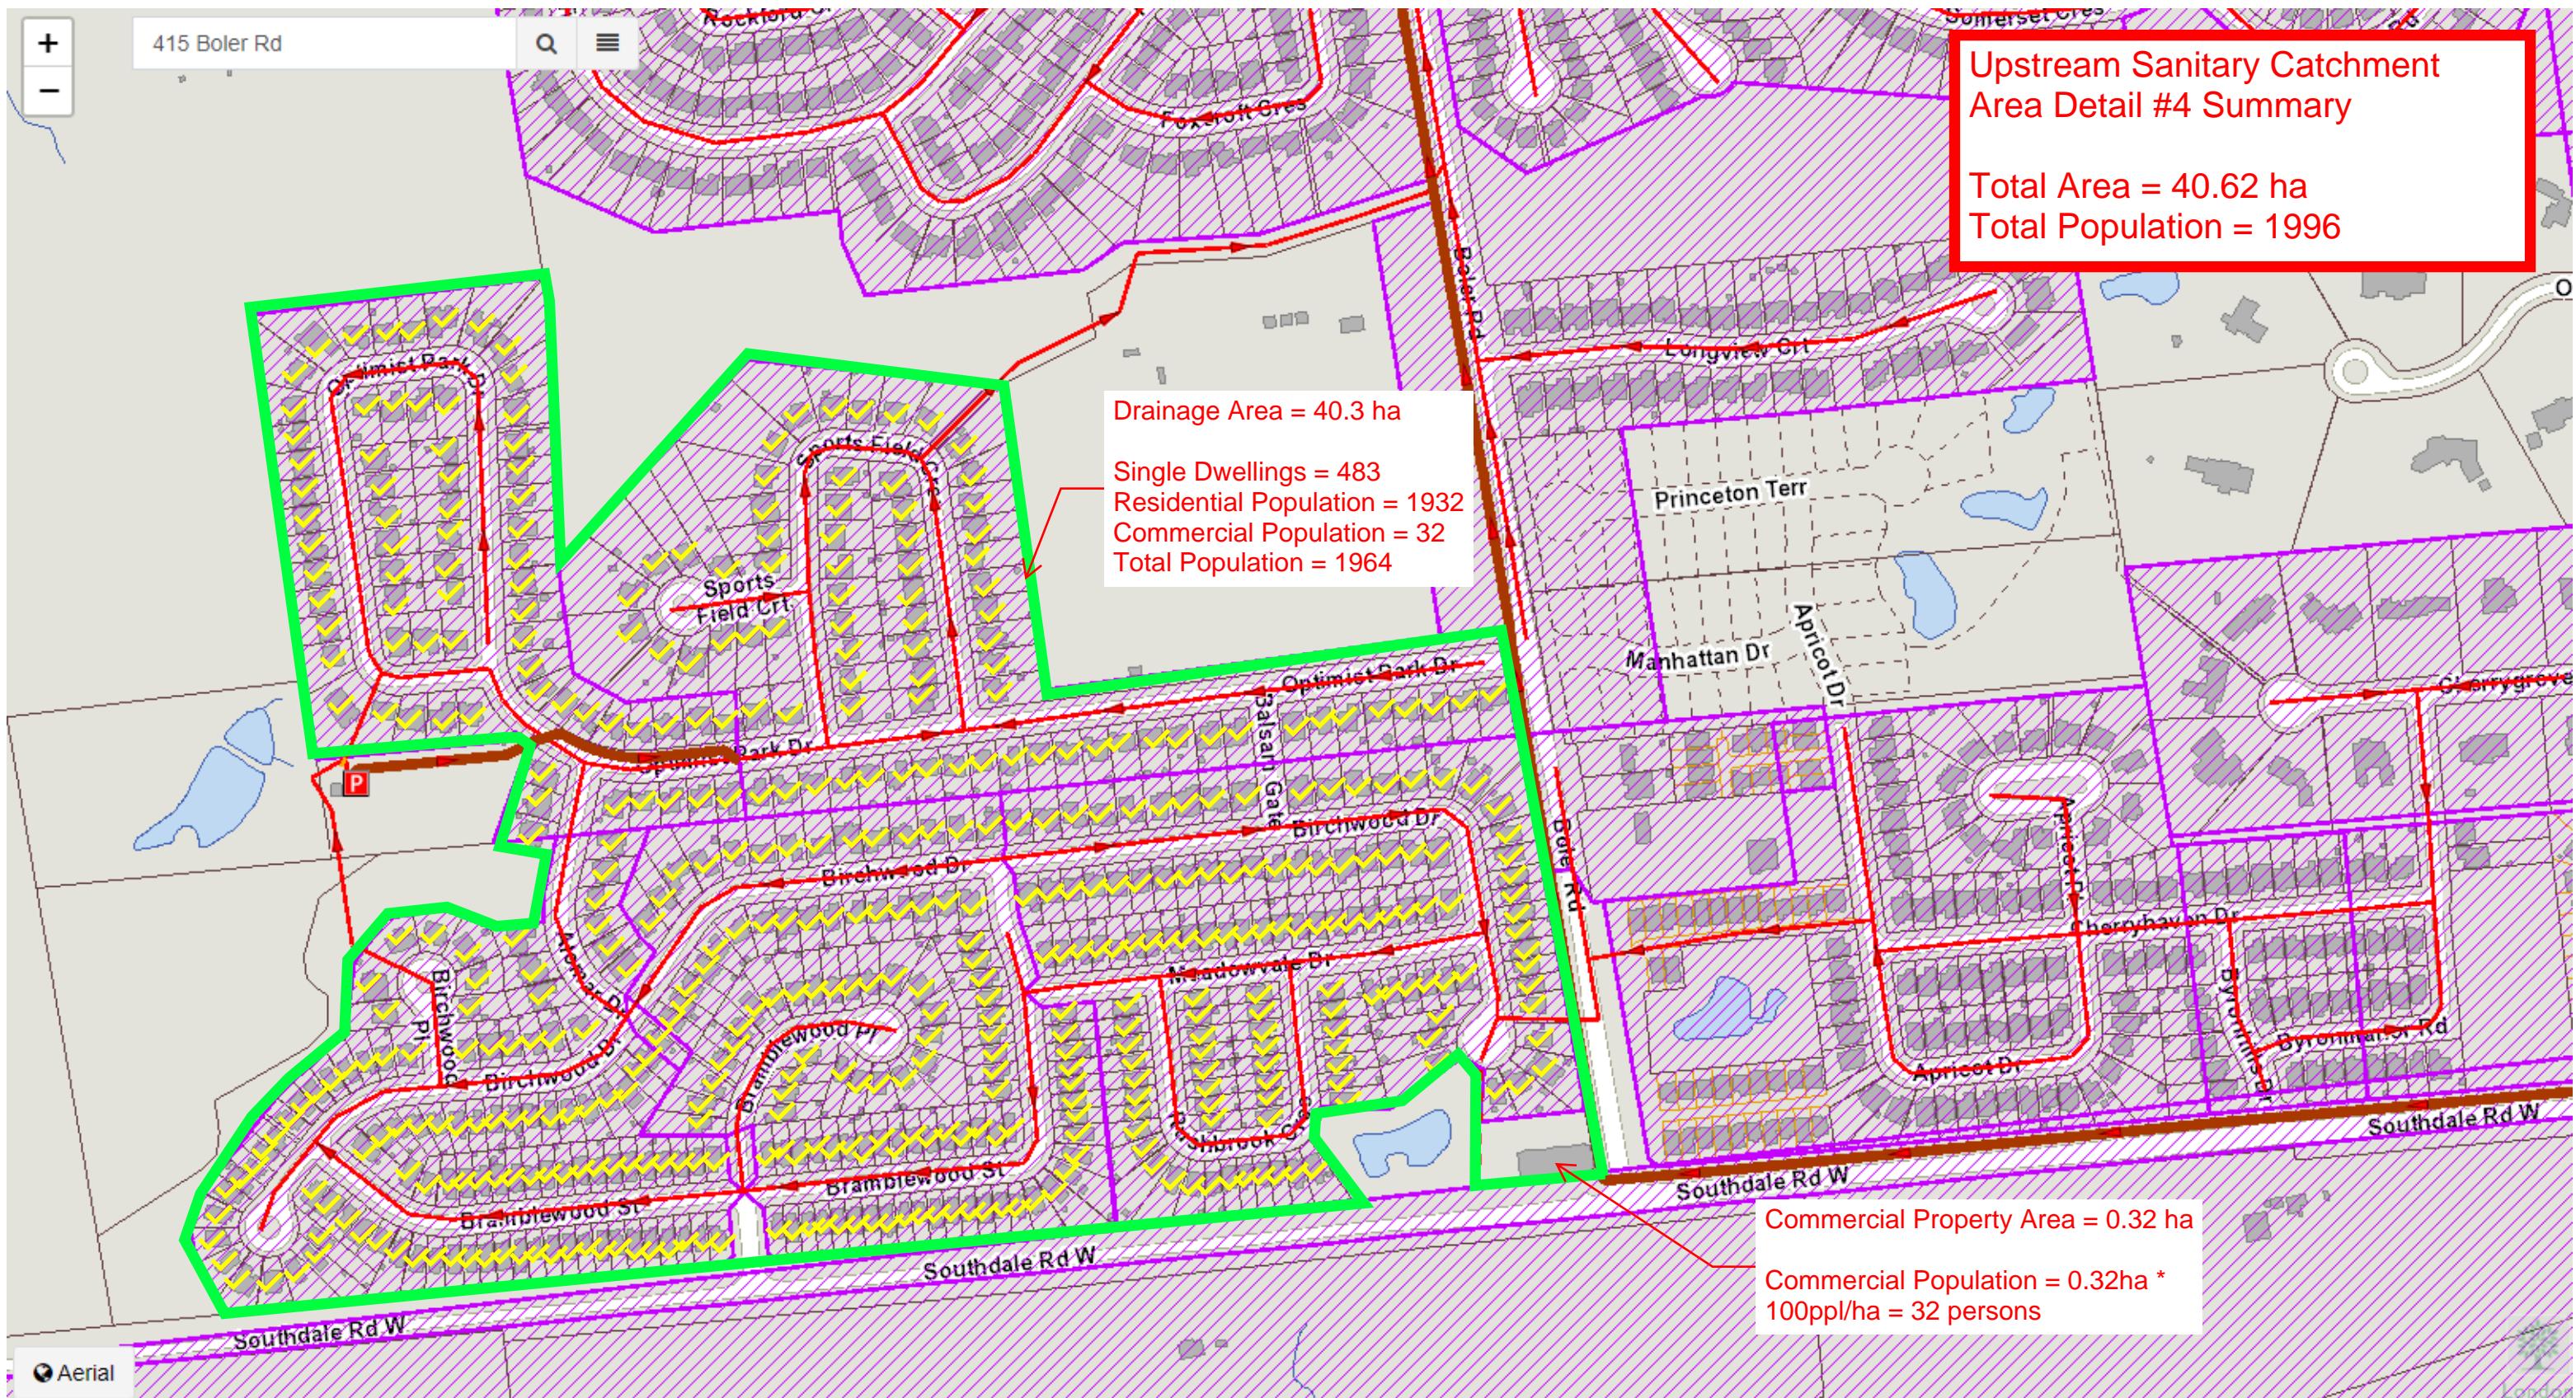

Boler Road 250mm Sanitary Forcemain Detail

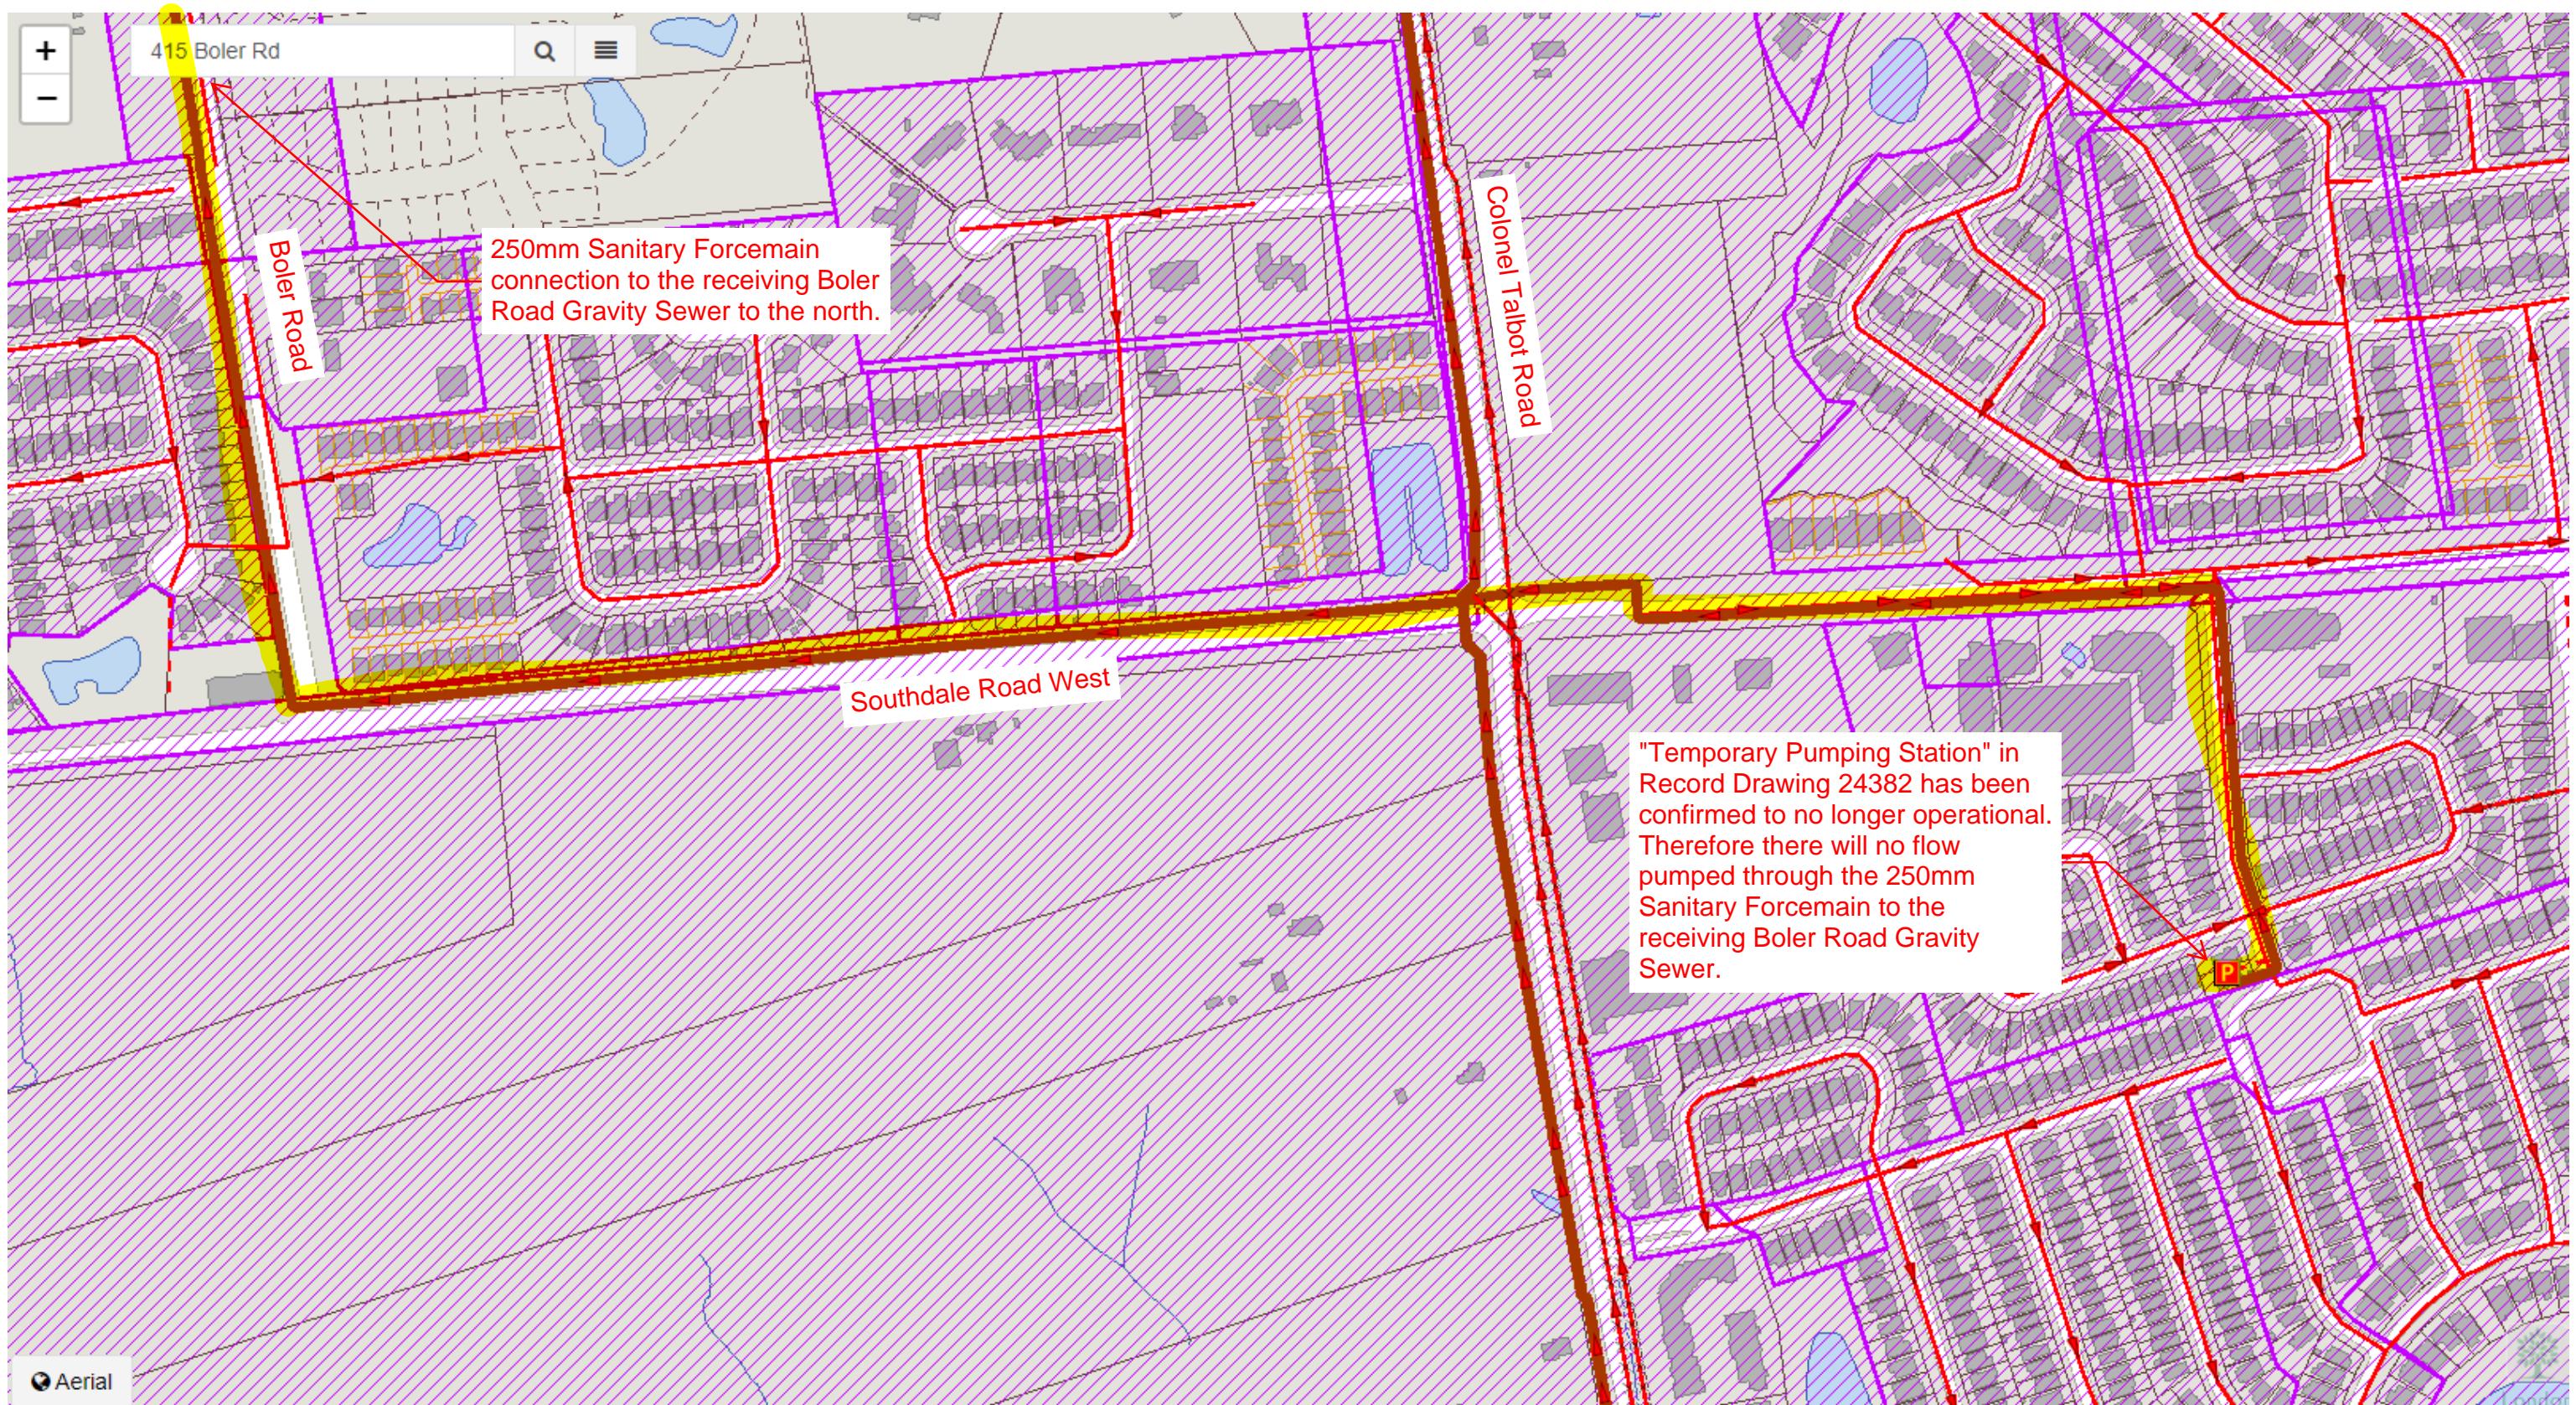

Sanitary Service Design Sheet

City of London

Residential Population Densities

(A) Area Basis

Low Density Residential (Single Family/Semi-Detached)	= 30 Units/hectare @ 3 people/unit
Medium Density Residential (Multi-Family/Townhouse)	=75 Units/hectare @ 2.4 people/unit
High Density Residential (Apartment Buildings)	=150-300 Units/hectare @ 1.6 people/unit
Commercial = 100 people/hectare	
Low Density Residential (Per 1964 & 1698 Sanitary Design Sheets)	= 4 people/unit

Design Parameters
 Daily Flow (L/cap/day) 230
 Sewage Infiltration (Litres/hectare/day) 8640
 Harmon Formula (Peaking Factor)
 $M = (1 + 14/(4+P^0.5))$
 Uncertainty Factor 1.1

Date: June 2, 2022

Job Number: SBM-22-0021

Client: York Developments (London) Inc.

Project: Proposed 6 Story Residential Building

Location: 415 Boler Road, London, Ontario

Designed By: KJC/LA

Reviewed By: RF

Location			Area				Population			Sewage Flows				Sewer design								
Area No.	From MH*	To MH*	Delta Acre	Total Acre	Delta Hectare	Total Hectare	No. of Units/Lots	People Per Unit/Lots	People Per Hectare	Delta Pop.	Total Pop.	Harmon Peaking Factor	Infilt L/S	Sewage L/S	Total L/S	n	Pipe Slope %	Dia. mm	Capacity L/S	Percentag e Full %	Velocity m/s	
Upstream Conditions																						
Boler Road	60	Base Line (59)			-	172.6 *		-	-		7280*	3.09	17.26	65.87	83.13	0.013	1.04%	375	178.91	46.47	1.62	
Proposed Development																						
415 Boler Road			0.803	0.803	0.325	0.325	90.0	1.6	-	144	144	4.20	0.03	1.77	1.80							
Downstream Conditions																						
Boler Road (Inc. 415 Boler Rd)	Base line (59)	58	3.0	3.0	1.2	173.8	1.0**	4.0	-	248***	7528	3.08	17.38	67.81	85.19	0.013	1.03%	375	178.05	47.85	1.61	
Boler Road		58	2.0	5.0	0.8	174.6	10.0	4.0	-	40	7568	3.07	17.46	68.12	85.58	0.013	1.06%	375	180.62	47.38	1.64	
Boler Road		57	2.0	7.0	0.8	175.4	11.0	4.0	-	44	7612	3.07	17.54	68.46	86.00	0.013	1.15%	375	188.13	45.71	1.70	
Boler Road		56	Guest (55)	2.0	9.0	0.8	176.2	12.0***	4.0	-	48	7660	3.07	17.62	68.83	86.45	0.013	1.07%	375	181.47	47.64	1.64
Guest St	Byron	Boler	2.0	2.0	0.8	0.8	10.0***	4.0	-	40	40	4.33	0.08	0.51	0.59	0.013	0.58%	200	24.99	2.36	0.80	
Boler Road	Guest (55)	54	2.8	13.8	1.1	178.2	5.0	4.0	-	0	7700	3.07	17.82	69.14	86.96	0.013	0.40%	450	180.42	48.20	1.13	
Boler Road		54	Norman (53)	2.8	16.6	1.1	179.3	8.0	4.0	-	32	7732	3.06	17.93	69.39	87.32	0.013	0.44%	450	189.23	46.14	1.19
Boler Road		Norman (53)	Spring Bank (52)	2.8	19.4	1.1	180.5	9.0	4.0	-	36	7768	3.06	18.05	69.67	87.72	0.013	0.49%	450	199.69	43.93	1.26
Springbank Ave	Lot 26 (153)	Boler	2.1	2.1	0.8	0.8	19.0	-	-	84	84	4.26	0.08	1.05	1.13	0.013	0.58%	200	24.99	4.52	0.80	
Boler Road	Spring Bank (52)	Comm. (51)	3.1	24.6	1.3	182.6	4.0	-	-	124	7976	3.05	18.26	71.27	89.53	0.013	0.42%	450	184.88	48.43	1.16	
Commissioners Road West	Lot 50	Boler	1.7	1.7	0.7	0.7	5.0	-	-	68	68	4.29	0.07	0.85	0.92	0.013	0.61%	200	25.63	3.59	0.82	
Commissioners Road West	Boler (51)	50	1.6	27.9	0.6	183.9	4.0	-	100	84****	8128	3.04	18.39	72.44	90.83	0.013	0.27%	450	148.23	61.27	0.93	

*Total upstream population and drainage area confirmed based on City of London Locates Website calculated areas and dwelling counts. See attached PDF markups for additional details.

** Residential Units reduced to 1 resulting from proposed development

*** Population includes 4 from single residential unit, 100 from church, and 154 from proposed development

****12 residential units counted from London Mapping

*****10 residential units counted from London Mapping

***** 84 person population calculated based on commercial area

Refer to Site Plan prepared by Philip Agar Architect Inc.

Design Parameters obtained from Section 3.8 in the City of London DS&RM

Downstream conditions based on City of London drawing 5415 dated November 1964