

Brock Development Group Inc.
1584 Routledge Park,
London, ON N6H 5L6

24 May 2022
SBM-22-1218

Attn: Ms. Michelle Doornbosch

**Re: Servicing Feasibility Study
Proposed Residential Development
1170 Fanshawe Park Road East, London, Ontario**

1. INTRODUCTION

This Servicing Feasibility Study (Study) has been prepared by Strik, Baldinelli, Moniz Ltd. (SBM) for Brock Development Group Inc. to address the servicing feasibility for the proposed residential development located at 1170 Fanshawe Park Road East, London. The site is approximately 0.37 ha in area.

The site abuts the Stackhouse Avenue Right-Of-Way (ROW) to the west, Fanshawe Park Road E ROW to the south, an existing residential zone in the southeast corner, agricultural lands to the north and neighborhood facility zone to the northeast corner. See the proposed site plan by Brock Development Group enclosed with this Study.

This Study is to determine the adequacy of the existing City services in support of a Zoning Bylaw Application (ZBA), an official Plan Amendment, and the Site Plan Approval (SPA) application for the proposed redevelopment.

Design requirements have been based on the City of London Design Specifications & Requirements Manual (DS&RM), updated March 2022.

2. WATER SERVICING

As per the City's record drawing 27115, dated as constructed February 24, 2017, there is an existing 400mm PVC watermain on south side of Fanshawe Park Road East. The single 25 mm diameter existing water service connection for 1170 Fanshawe Park Road East per City Record drawing 27115 will be proposed to be decommissioned.

2.1 Domestic Water Supply

Domestic water supply will be provided via the existing watermain on Fanshawe Park Road East. The maximum hour domestic demand, as per the DS&RM for the building occupancy load of 63 people (26 Units at 2.4 people per unit) is 1.45 L/s. See the attached domestic water demand calculations.

2.2 Water Supply for Fire Protection

The proposed residential development is a Part 9 building (3-Storeys high or less and less than 600 m²), therefore no sprinkler system is required for this development.

Section 7.3.1 of the DS&RM, updated March 2022, requires the minimal residual pressure in a fire flow scenario to be not less than 140 kPa (20 psi) at any hydrant lateral or fire service connection. Section 7.3.1 of the DS&RM also requires that the maximum residual pressure shall not exceed 550 kPa (80 psi).

Upon review of the hydrant flow test results (attached to this Study) as tested on November 18, 2015 and using linear interpolation of the residual pressure readings at the provided flow rates from the hydrant, there is sufficient residual pressure within the system. The flow test results show that the static pressure of the water distribution system in the area is 468.84 kPa (68 psi) and the residual pressure is 448.16 kPa (65 psi) at the test flow rate of 4,391 L/min (1160 USGPM). At the required fire flow + maximum day demand rate of 5439 L/min, the residual pressure in the water main would be approximately 457.56 kPa (66.36 psi) which exceeds the minimum required 140 kPa (20 psi) in fire-flow scenarios and does not exceed the maximum residual pressure of 550 kPa (80 psi). Please refer to the calculations attached to this Study.

Based on the current OBC requirements, a fire hydrant should be located 90 m from the subject property's edge of the building. As per the City's record drawing 27115, dated as constructed February 24, 2017, there is an existing municipal hydrant at the southeast side of Fanshawe Park Road East located at a distance which is greater than 90 m from the subject property's edge of the building. Based on the location of the existing hydrant, a new on-site hydrant will be required. The location of the hydrant will be determined at the time of Site Plan Approval.

The fire-fighting flow calculations is determined as per OBC A-3.2.5.7. Since the proposed building is a residential development, the building is classified as group C (Refer to OBC volume 1 table 3.1.2.1). Type of construction is combustible. To be more conservative, water supply coefficient – K is assumed to be 23 (Refer to OBC volume 2 table 1). Building area is equivalent to the most conservative one which is approximately 373.31 m². As per the Site Plan by Brock Development Group attached to this Study, unit 20 abuts units 18 and 22 to the east and west, unit 16 to the north, and the road to the south. Therefore, the spatial coefficient S_{Total} is calculated to be 1.8. Refer to the calculations attached to this Study.

2.3 *Water Supply Conclusions*

As shown in the attached Domestic and Fire-Flow Water Servicing Calculations (considering the hydrant flow test, OBC A-3.2.5.7 flow demand requirements, and maximum day domestic demand), the water pressure in the Fanshawe Park Road East watermain at the required flow of 5439 L/min (fire flow + maximum day demand), will be around 66.36 psi. It can be concluded that adequate water supply for the proposed development is available from the municipal system with residual pressures greater than the minimum requirement of 140 kPa (20 psi) and does not exceed the maximum requirement of 550 kPa (80 psi).

Based on the above and the Fire-Flow calculations attached, we recommend that a 250 mm diameter water service to be considered for preliminary design purposes for the subject address and proposed development, connected to the existing 400 mm PVC watermain. A new on-site fire hydrant will be required, that will provide the fire protection. Domestic water services will probably be 25 mm per unit, connected to the recommended 250 mm diameter water service.

3. SANITARY SERVICING

The sanitary service connection for the proposed site development is assumed to connect to the existing 150 mm diameter sanitary sewer stub (invert at 252.749) as seen in the City's record drawing 23144 dated March 6, 2012, with the size to be confirmed at the time of Site Plan Approval. As per the City's record drawing 23144 dated March 6, 2012, the site is tributary to the 600 mm diameter sanitary sewer in the Stackhouse Avenue ROW.

The proposed flows from the subject property are shown on the Sanitary Sewer Design Sheet appended to this Study. Using a flow of 230 L/capita/day as per the DS&RM for the building occupancy load of 63 people (26 units at 2.4 people per unit) results in an anticipated peak sanitary flow of 0.79 L/s. When combined with infiltration, this results in a total peak flow of 0.83 L/s. Preliminarily, the existing 150 mm sanitary service stub per City record drawing 23144 at a slope of 7.3% has sufficient capacity to convey these proposed flows and should be considered for preliminary design purposes.

The site is ultimately tributary to the 600 mm diameter sanitary sewer on Fanshawe Park Road East. According to the City's record drawing 23137 Stoney Creek Trunk Sanitary Sewer Design Sheet, dated as constructed January 12, 2012 (Sealed March 6, 2012), the total sewage flow at this location is 223.7 L/s with a capacity of 245.99 L/s (using the sewage flow of 250 L/cap/day). As per 2022 DSRM, the daily flow has been updated in our calculations to reflect 230 L/cap/day. This updated flow combined with the proposed flow of 0.83 L/s produces a total flow of 208.17 L/s which does not exceed the sanitary sewer's capacity of 245.99 L/s. Therefore, there appears to be sufficient capacity in the receiving sewers immediately downstream of the proposed development.

4. STORM SERVICING AND STORMWATER MANAGEMENT

As per the City's record drawing 27101, dated February 24, 2017, the site is tributary to the existing 675 mm diameter storm sewer on Stackhouse Avenue, with a runoff coefficient (C-value) of 0.72 under existing conditions. The proposed site has an existing 300 mm diameter storm service stub on Stackhouse Avenue (found within EXT'L-1 on the City's record drawing 27101).

A Storm/Drainage Servicing Report demonstrating compliance with the SWM criteria and environmental targets identified in the Stoney Creek Subwatershed Study (quality control of 80% TSS removal) will be assessed at the time of Site Plan Approval.

The SWM calculations attached to this Study show that the post development C-value of 0.74 for the entire site is greater than the allowable C-value of 0.72 per City record drawing 27102. Therefore, storm water management quantity controls are proposed for this development. It is proposed to connect a storm service to the existing storm servicing stub at 2U327 in the Stackhouse Avenue to convey minor flows (2-year allowable storm event), while major flows (up to the 100-year storm event) will be managed (stored) on-site. The 250-year storm event will be safely conveyed overland to the Fanshawe Park Road East ROW or the Stackhouse Avenue ROW. Detailed SWM calculations shall be submitted with the first SPA submission.

5. SUMMARY

Based on the above, the existing city infrastructure and proposed site services have sufficient capacity to accommodate the proposed development of the 0.37 ha subject site located at 1170 Fanshawe Park Road East, London.

6. LIMITATIONS

This Study was prepared by Strik, Baldinelli, Moniz Ltd. for Brock Development Group Inc. and the City of London. Use of this Study by any third party, or any reliance upon its findings, is solely the responsibility of that party. Strik, Baldinelli, Moniz Ltd. accepts no responsibility for damages, if any, suffered by a third party as a result of decisions made or actions undertaken as a result of this Study. Third party use of this Study, without the express written consent of the Consultant, denies any claims, whether in contract, tort, and/or any other cause of action in law, against the Consultant.

All findings and conclusions presented in this Study are based on site conditions as they appeared in the information presented to SBM and related to in this document. This Study is not intended to be exhaustive in scope, or to imply a risk-free development. It should be recognized that the passage of time may alter the opinions, conclusions, and recommendations provided herein, as well as any changes in the layout of the development.

The design was limited to the documents referenced herein and Strik, Baldinelli, Moniz Ltd. accepts no responsibility for the accuracy of the information provided by others. All designs and recommendations presented in this Study are based on the information available at the time of the review.

This document is deemed to be the intellectual property of Strik, Baldinelli, Moniz Ltd. in accordance with Canadian copyright law.

7. CLOSURE

We trust this Study meets your satisfaction. Should you have any questions or require further information, please do not hesitate to contact us.

Respectfully submitted,

Strik, Baldinelli, Moniz Ltd.

Planning • Civil • Structural • Mechanical • Electrical




Ryan Frouws, P.Eng.
Civil Eng II, Project Lead

Encl: Site Plan by Brock Development Group.
City of London record drawings 27115
Domestic Water Demand Calculations
Hydrant Flow Test
Fire Flow Calculations (as per OBC A-3.2.5.7)
City of London record drawings 23144 and 23137
Sanitary Service Design Sheet
City of London record drawings 27101 and 27102
Runoff Coefficient Calculations



Rawan Safieddine
Civil EIT I

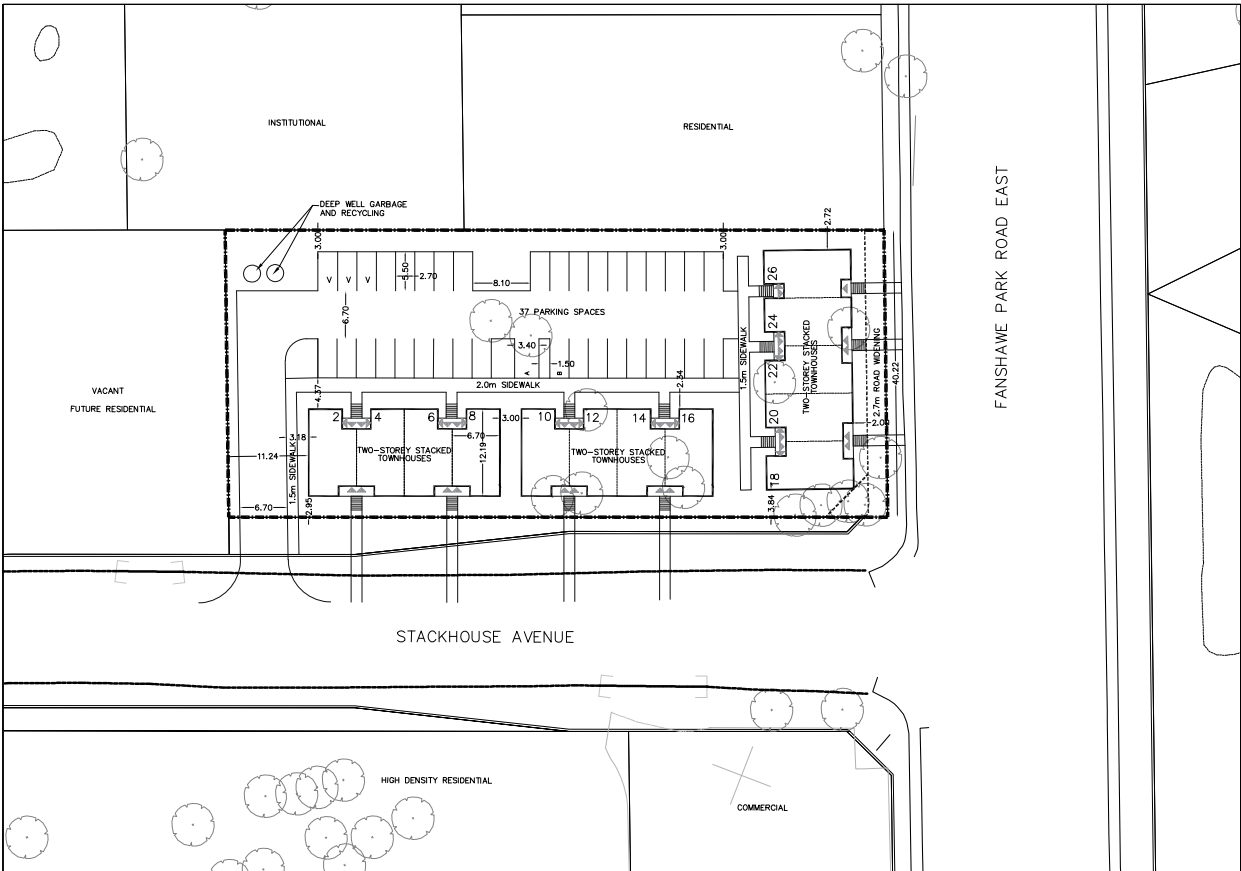

KEY PLAN

PROPOSED SITE PLAN
 CONC 5, PART LOT 10 REG
 (GEOGRAPHIC TOWNSHIP OF LONDON
 CITY OF LONDON
 COUNTY OF MIDDLESEX)

SITE STATISTICS
 PROPOSED R6-4(*) ZONE

	REQUIRED	PROPOSED
LOT AREA	0.20 ha	0.37 ha
LOT FRONTAGE	22.0 m	38.2 m
LOT DEPTH	N/A	105.5 m
FRONT YARD SETBACK	6.0 m	2.0 m
EXT. YARD SETBACK	6.0 m	2.0 m
SIDEYARD SETBACK (N)	6.0 m	11.2 m
SIDEYARD SETBACK (E)	6.0 m	2.7 m
LANDSCAPED AREA	30%	41%
LOT COVERAGE	40%	59%
HEIGHT	10.5 m	~12m
DENSITY	30 UPM	70 UPM
PARKING	39 SPACES	37 SPACES


DRAWING BASED ON CITY OF LONDON
 BASE MAPPING

NO.	REVISION	DATE	INITIAL


1170 FANSHAWE
 PARK ROAD EAST



DATE: DECEMBER 2021 PROJECT NO.: SCALE: 1:500

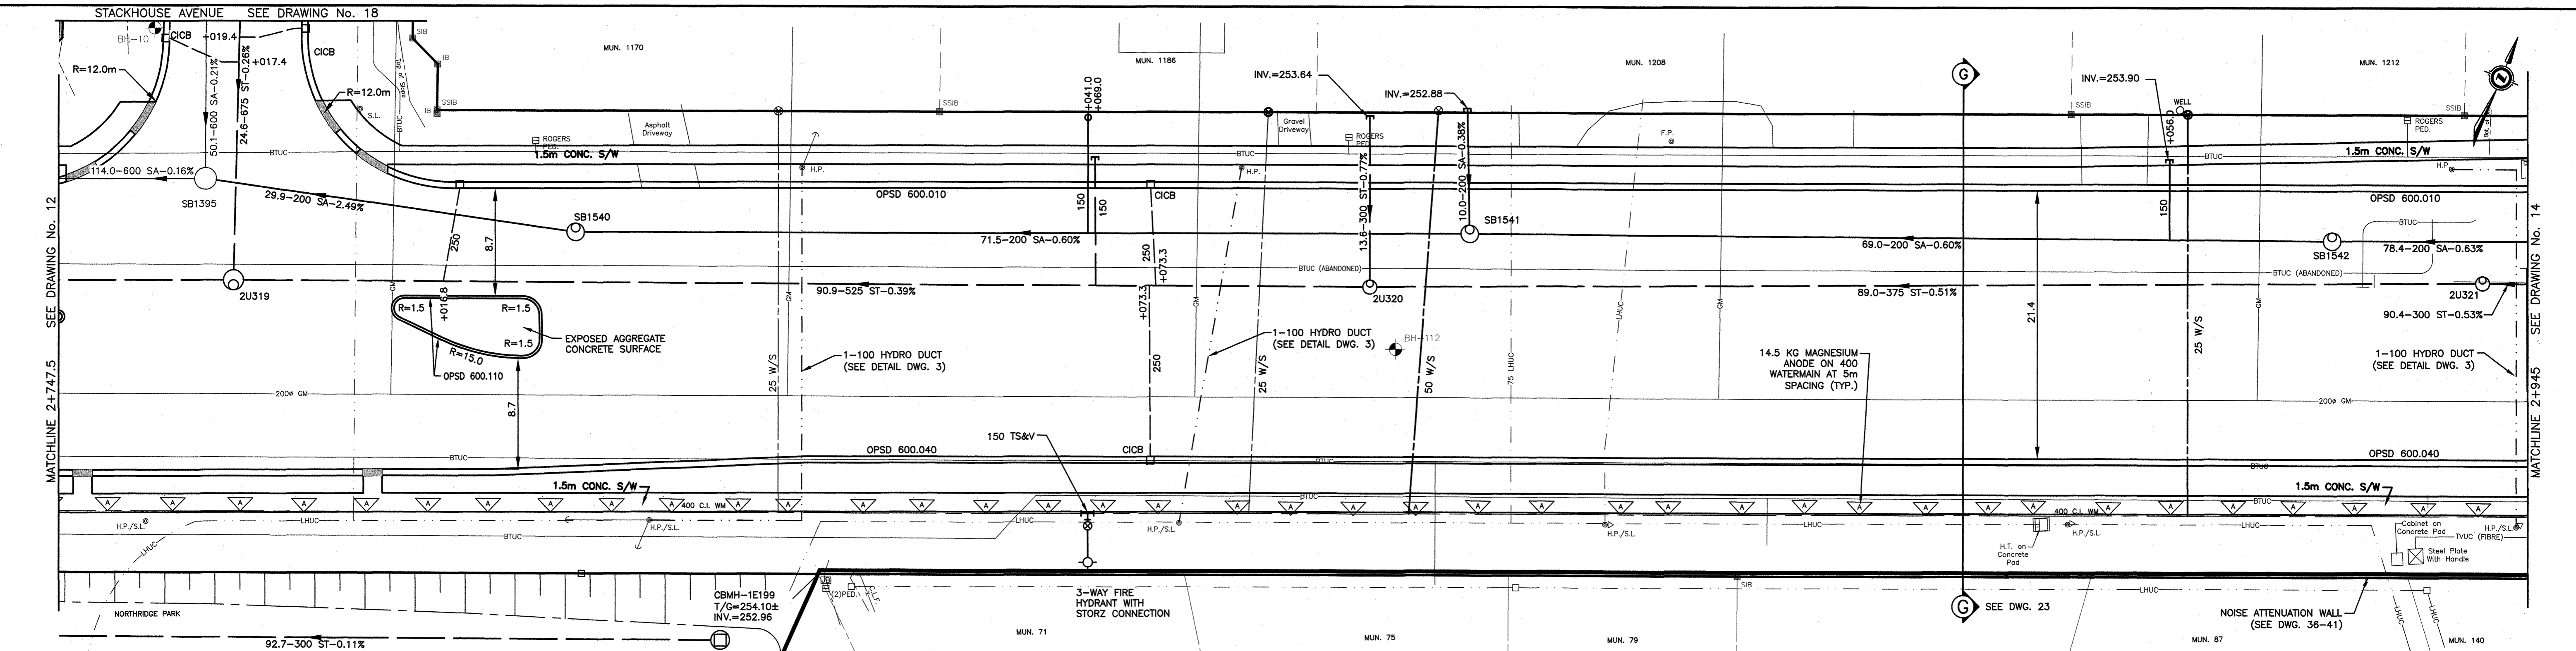

FANSHAWE PARK ROAD

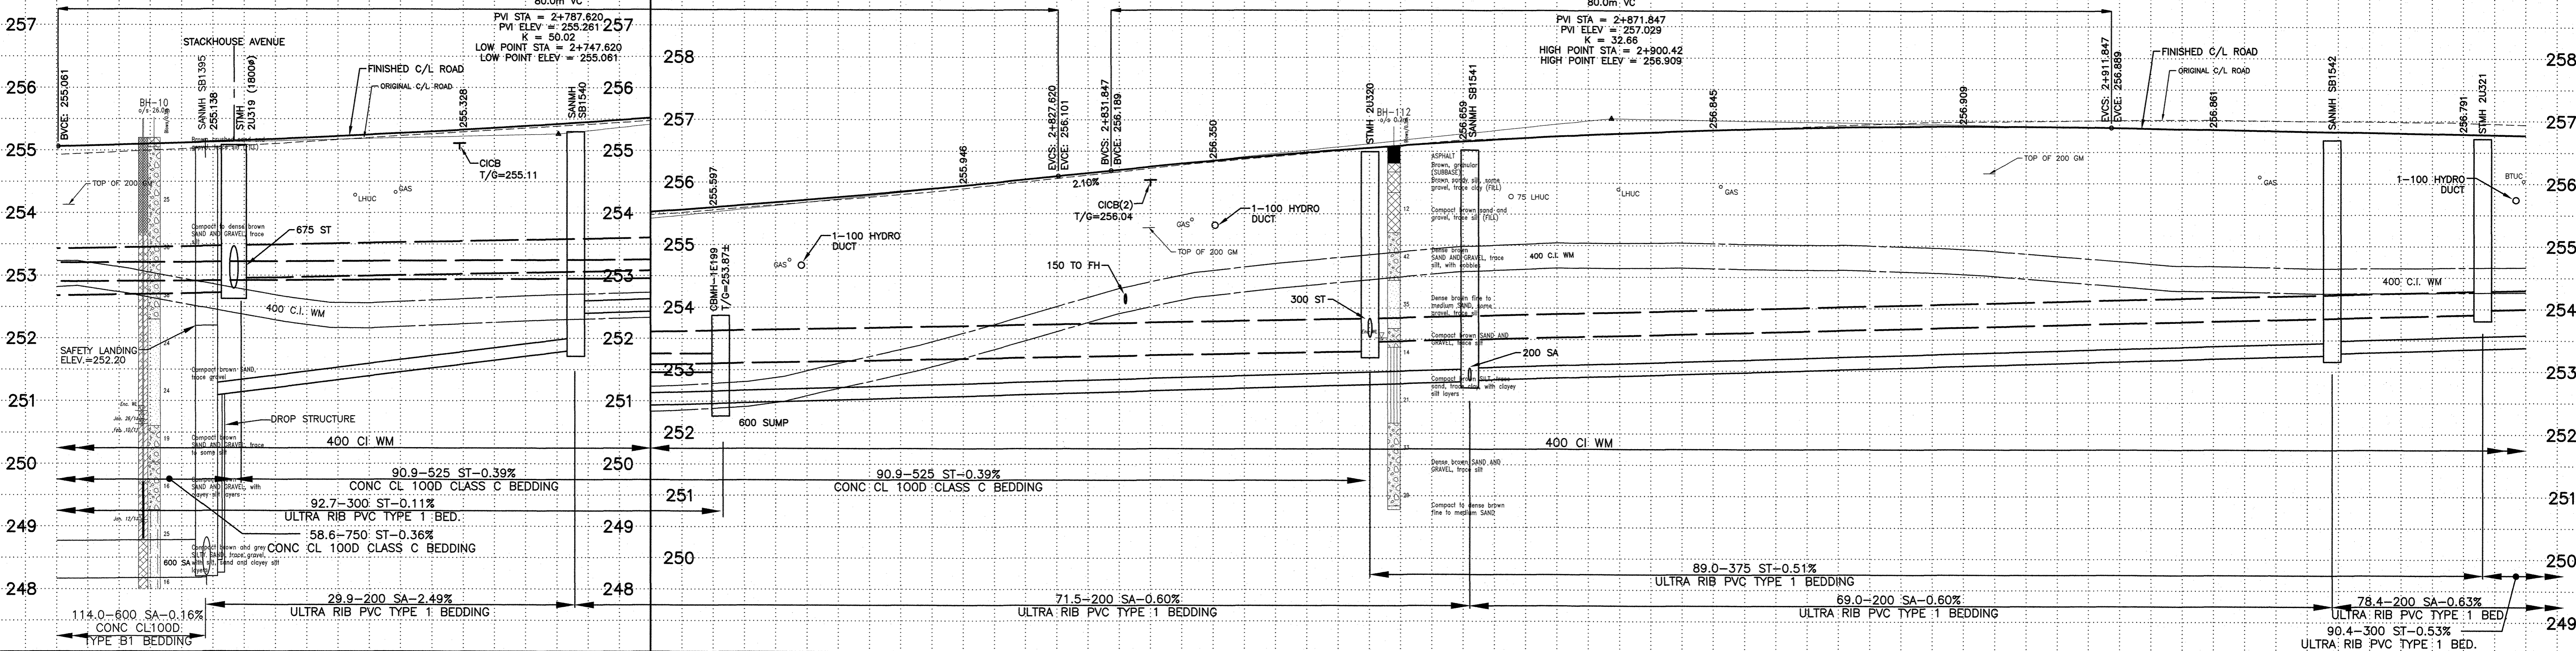

STATION	SANITARY INVERT	STORM INVERT	C/L WATERMAIN ELEVATION
2+747.16	248.19W	253.04	253.04
2+759.49	248.22N	252.37	252.37
2+760	248.22N	252.36	252.36
2+761.67	251.067E	252.49	252.49
2+764.41	252.730W	252.61	252.61
2+775.52	252.954E	252.70	252.70
2+780	252.792N	252.80	252.80
2+786.27	252.963W	253.20	253.20
2+789.00	252.395E	253.67	253.67
2+800.60	252.963W	254.10	254.10
2+802.74	253.458E	254.36	254.36
2+805.68	253.335N	254.52	254.52
2+816.50	253.307W	254.68	254.68
2+820	253.458E	254.78	254.78
2+824.92	253.335N	254.84	254.84
2+832.43	253.335N	254.84	254.84
2+836.54	253.820W	254.85	254.85
2+840	253.458E	254.81	254.81
2+843.33	253.335N	254.78	254.78
2+850.54	253.820W	254.73	254.73
2+853.94	253.458E	254.55	254.55
2+862.74	253.335N	254.49	254.49
2+867.44	253.820W	254.47	254.47
2+871.63	253.458E	254.44	254.44
2+877.43	253.335N	254.45	254.45
2+880	253.820W	254.45	254.45
2+890.60	253.458E	254.47	254.47
2+896.49	253.335N	254.44	254.44
2+900	253.820W	254.45	254.45
2+901.76	253.458E	254.45	254.45
2+912.86	253.335N	254.49	254.49
2+916.74	253.820W	254.47	254.47
2+920	253.458E	254.44	254.44
2+921.90	253.335N	254.45	254.45
2+929.50	253.820W	254.45	254.45
2+935.79	253.458E	254.47	254.47
2+940	253.335N	254.44	254.44
2+941.54	253.820W	254.45	254.45
2+943.97	253.458E	254.47	254.47

EXISTING SERVICES	DRAWING #, SOURCE	DATE	AS CONSTRUCTED SERVICES	COMPLETION	DETAILS	No.	REVISIONS	DATE	CONSULTANT
SAN/STM SEWERS, PDGS & M/S	23143	JAN. 2012	SAN/STM SEWERS, PDGS & M/S	NOV. 2016	DESIGN	1.	ISSUED FOR 50% REVIEW	MARCH 27/15	AECOM
WM AND WSC'S	23143	JUNE 1984	WM AND WSC'S	NOV. 2016	DRAWN BY	2.	ISSUED FOR 90% REVIEW	AUGUST 21/15	AECOM
			CURB AND GUTTER	NOV. 2016	CHECKED	3.	ISSUED FOR 100% REVIEW	NOVEMBER 4/15	AECOM
			GRANULAR BASE	OCT. 2016	APPROVED	4.	ISSUED FOR TENDER	DECEMBER 2/15	AECOM
			PAVING - I BASE	NOV. 2016	DATE	5.	AS-CONSTRUCTED	FEBRUARY 24/17	AECOM
			- II BASE	MAY 2017					

London, Ontario
519.673.0510

D.C. CARPER
2017/1717

CORPORATION OF THE
CITY OF LONDON

SCALE

HORIZONTAL - 1:250

VERTICAL - 1:50

FANSHAWE PARK ROAD IMPROVEMENTS
ADELAIDE STREET TO McLEAN DRIVE

FANSHAWE PARK ROAD
FROM 365m EAST OF GLENORA DRIVE
TO 183m EAST OF STACKHOUSE AVENUE

PROJECT No. 60333430

SHEET No. 13

27115

DOMESTIC WATER DEMAND CALCULATION

DATE: May 24, 2022
JOB NO.: SBM-22-1218

Client: Brock Development Group Inc.
Project: Proposed Residential Development
Location: 1170 Fanshawe Park Road, London, Ontario

**Avg. Day Demand = 255 L/D/cap = 0.002951389 L/s/cap
**Max. Day Peaking Factor = 3.5
**Max. Hour Peaking Factor = 7.8
*Total Building Population = 63 People

	Units	*Population	Avg. Day (L/s)	Max. Hour (L/s)	Max. Day (L/s)
Townhouses	26	63	0.19	1.45	0.65
TOTAL:		63	0.19	1.45	0.65
					39 L/min

VELOCITY CALCULATION

Diameter (mm)	Demand (L/s) - Per Unit	Velocity (m/s)
25	0.06	0.113

Maximum allowable velocity of 1.5 m/s under maximum hour domestic flow conditions as per Section 7.3.6 of the City of London Design Specifications and Requirements Manual.


*Residential Building population based on 26 units (Medium density residential) at 2.4 person/unit as per Section 7.3.2.2 in DS&RM.

**Domestic Water Demands from Section 7.3.2.2 in DS&RM

WATER SUPPLY DEPARTMENT FLOW TESTS

DATE:	Wednesday, November 18, 2015	FLOW TEST No.		15-93
TIME:	9:00 AM	HYDRANT ID		H12627
OPERATOR:	Roger Ham	CHLORINE RESIDUAL mg/L		1.07
OPERATOR:	City Operator	POOR	GOOD	EXCELLENT
REQUESTED BY:	Spriet & Assoc - John M. Spriet			
LOCATION:	1300 Fanshawe Pk Rd E	TIME USED FOR FLUSHING		5 min

TEST NUMBER	FLOW HYDRANT					RESIDUAL HYDRANT	
	STATIC PRESSURE P.S.I.	OUTLET SIZE IN.	PITOT READING P.S.I.	INDIVIDUAL FLOW U.S.G.P.M	TOTAL FLOW U.S.G.P.M.	RESIDUAL PRESSURE P.S.I.	STATIC PRESSURE P.S.I.
1	65	2 1/2	48	890	1160	65	68
2		2 1/2	30	920	1840	65	
		2 1/2	30	920			

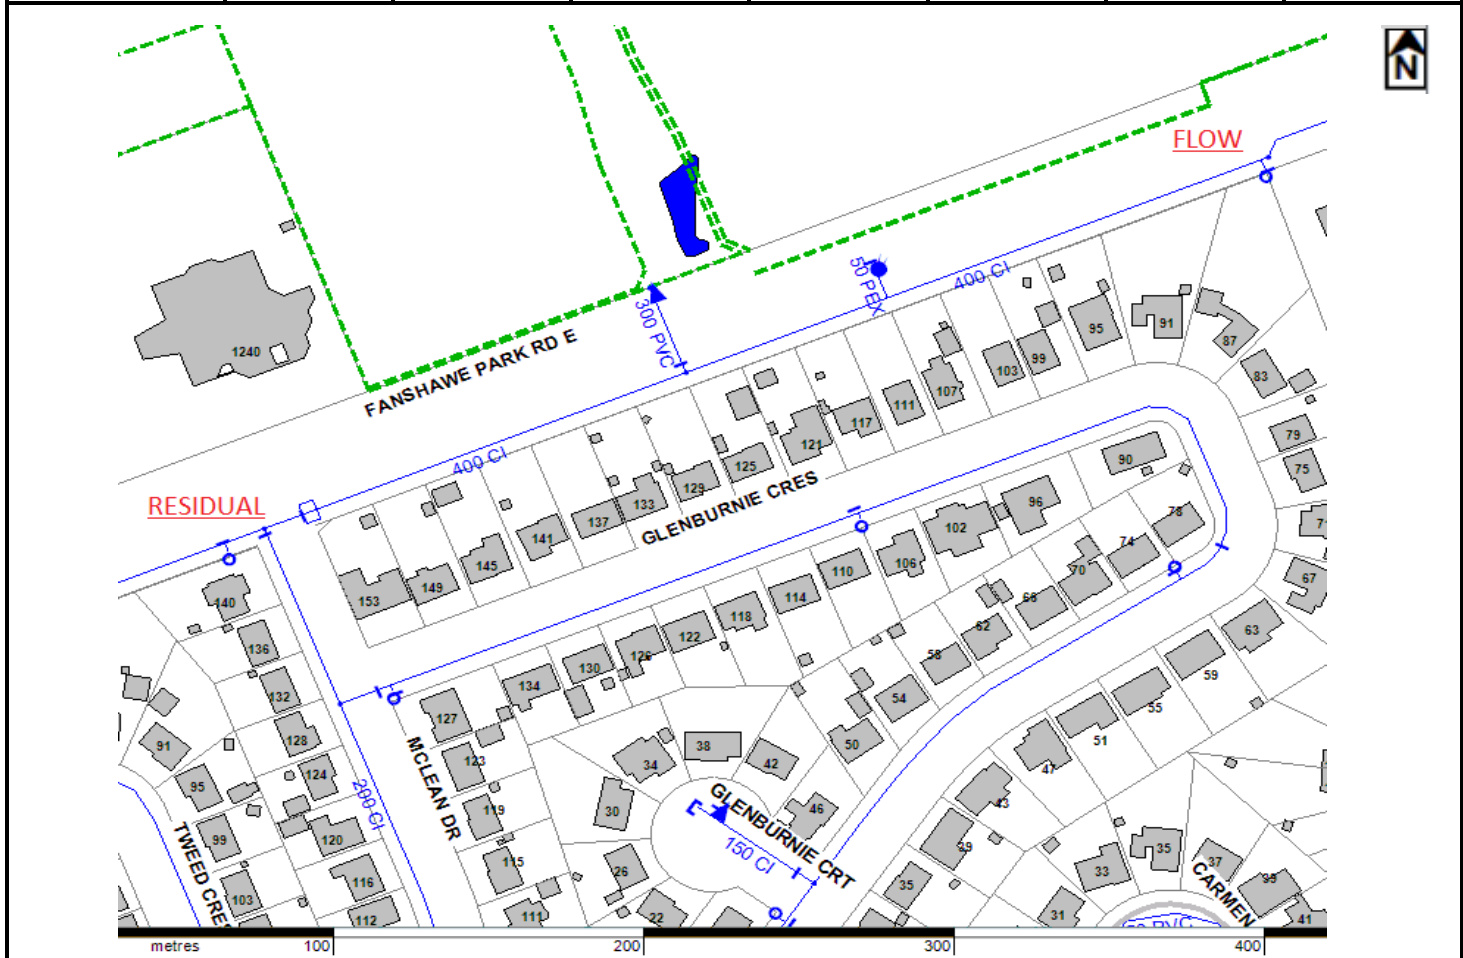

Information contained in this report is representative of flows and pressure losses at the time of the test and depends on reservoir levels, pump operation and customer water demand. Results will vary throughout the day and time of year. Available pressure at other times should be based on a design hydraulic grade line for the pressure zone in which the hydrants are located. By issuing this information report, neither the City nor any of its employees makes any warranty, express or implied, concerning the location, type or extent of services described in this report. Furthermore, neither the City nor any of its employees shall be liable in any manner for any personal injury or property damage or loss of any kind arising from or connected with this information or incomplete information.

Fire-Fighting Flow (OBC A-3.2.5.7.) Calculations

	For data entry
	Calculated, not for data entry

DATE:	May 20, 2022
JOB NO.:	SBM-22-1218

Client:	Brock Development Group Inc.
Project:	Proposed Stacked Townhouse Development
Location:	1170 Fanshawe Park Rd. E., London, Ontario

$Q=K*V*S_{Tot}$ Fire Flow Demand

Building Classification (3.1.2.1):	C	
Type of Construction:	Combustible	
K (Table 1):	23.00	To be conservative
Building Area, m ² :	373.31	
Building Height, m:	12.00	
Building Volume, m ³ :	4479.72	

$S_{Tot} = 1.0 + (S_{side1} + S_{side2} + S_{side3} + S_{side4})$

*S _{side1} (Figure 1) =	0.25	(North)
*S _{side2} (Figure 1) =	0.50	(East)
*S _{side3} (Figure 1) =	0.00	(South)
*S _{side4} (Figure 1) =	0.00	(West)
S _{Tot} =	1.8	
S _{Tot} < or = 2, therefore S _{Tot} =	1.8	

Q, L = 180309

Required Supply Flow Rate, L/min (OBC V2 Table 2) =	5400	= 90LPS
**Site Domestic Water Demand, L/min (Max. Day) =	39.00	
Total Required Flow Rate, L/min =	5439	

Hydrant Flow Test - 1300 Fanshawe Pk Rd E. Hydrant (H12627) Flow Test - 15-93				
Static Pressure	68.00	psi (468.84 kPa) =	0	L/min (0 USGPM)
Provided Supply Flow Rate @	68.00	psi (468.84 kPa) =	4391	L/min (1160 USGPM)
Provided Supply Flow Rate @	65.00	psi (448.16 kPa) =	6965	L/min (1840 USGPM)
Using linear interpolation, residual pressure at hydrant =	66.36	psi (457.56 kPa) =	5439	L/min (1437 USGPM)

Calculated Pressure Drop =	1.64	psi
Calculated Pressure Drop =	1.15	m head
HGL from DS&RM (Low Level System) =	301.80	m
Total Head Under Fire Flow Conditions =	300.65	m head
Approximate Elevation of Proposed Connection =	252.51	m***
Total Pressure Head =	48.14	m head

Water Pressure Under Firefighting Conditions Excluding Losses = 48.14 m head (68.45 psi, 471.97 kPa)


Therefore, water supply pressure at the proposed building under fire flow conditions not accounting for losses = 48.14 m head (68.45 psi, 471.97 kPa) which is greater than 140 kPa (20 psi) required per Section 7.3.1 of the City of London DS&RM.

*Refer to attached Figure 1 (Spatial Coefficient vs Exposure Distance)
 **Refer to attached Domestic Water Demand Calculations.
 ***Assumed From Plan and profile as built drawing 27115. To be confirmed at a later stage.


q = volume flow (L/s) [refer to fire-fighting demand calculations]	90.7	L/s
d = inside or hydraulic diameter (mm) [refer to drawing C3]	250	mm

Calculated Flow Velocity v = flow velocity (m/s)	1.85
---	------

Maximum allowable velocity of 2.4 m/s during fire flow conditions as per Section 7.3.6 of the City of London Design Specifications and Requirements Manual.

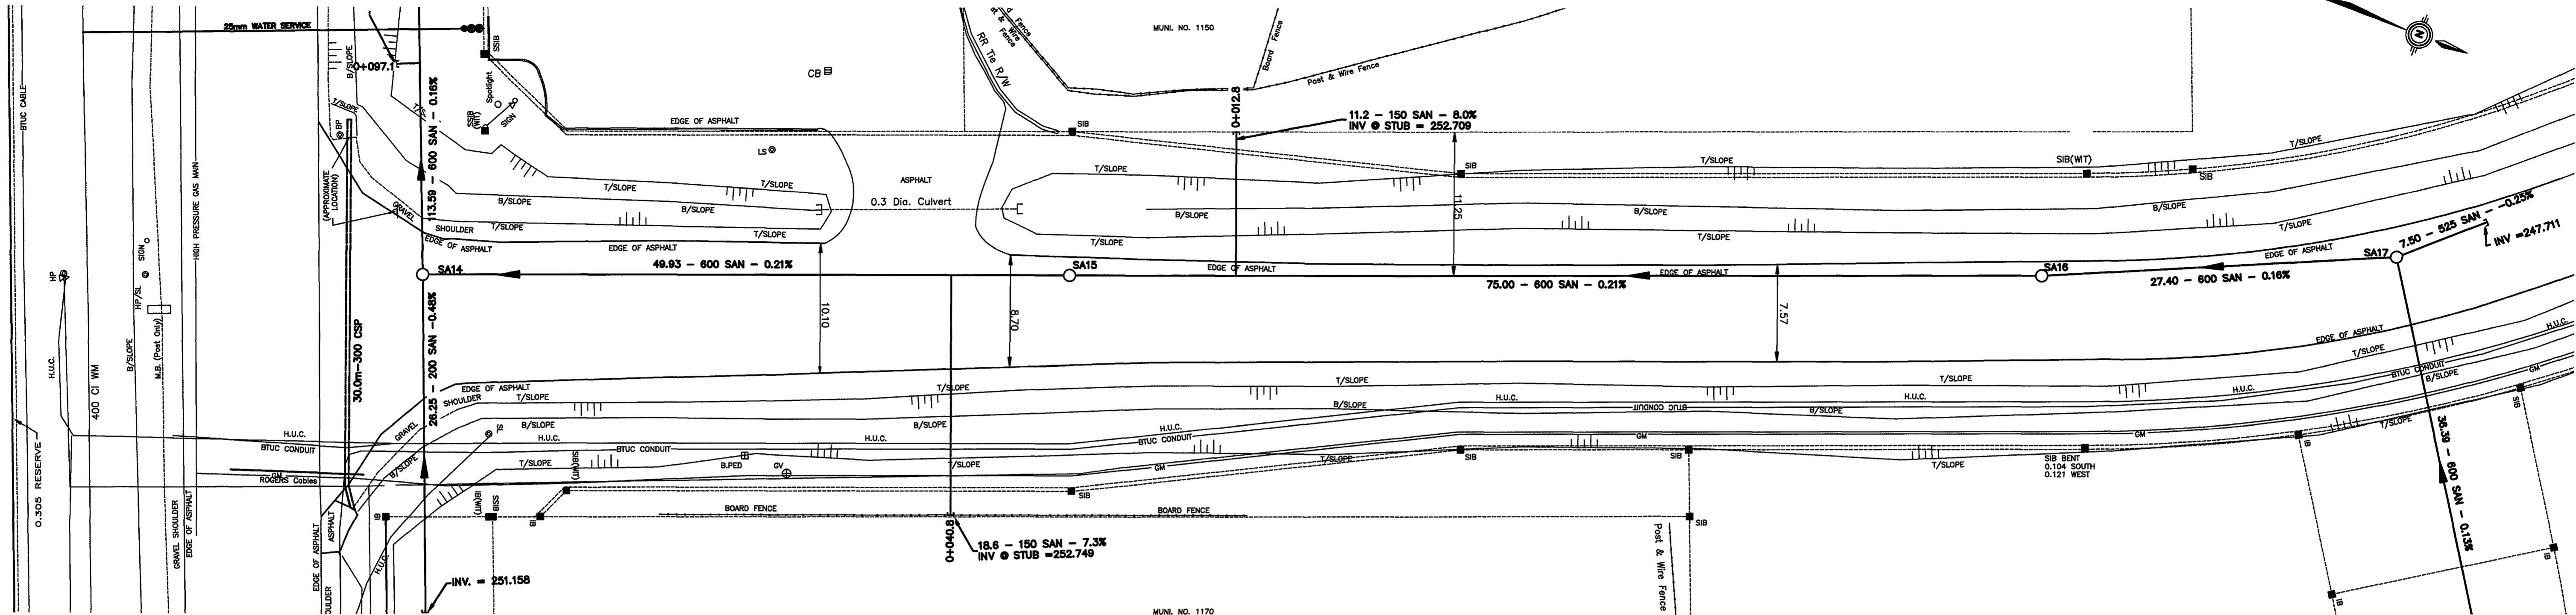

STACKHOUSE AVENUE

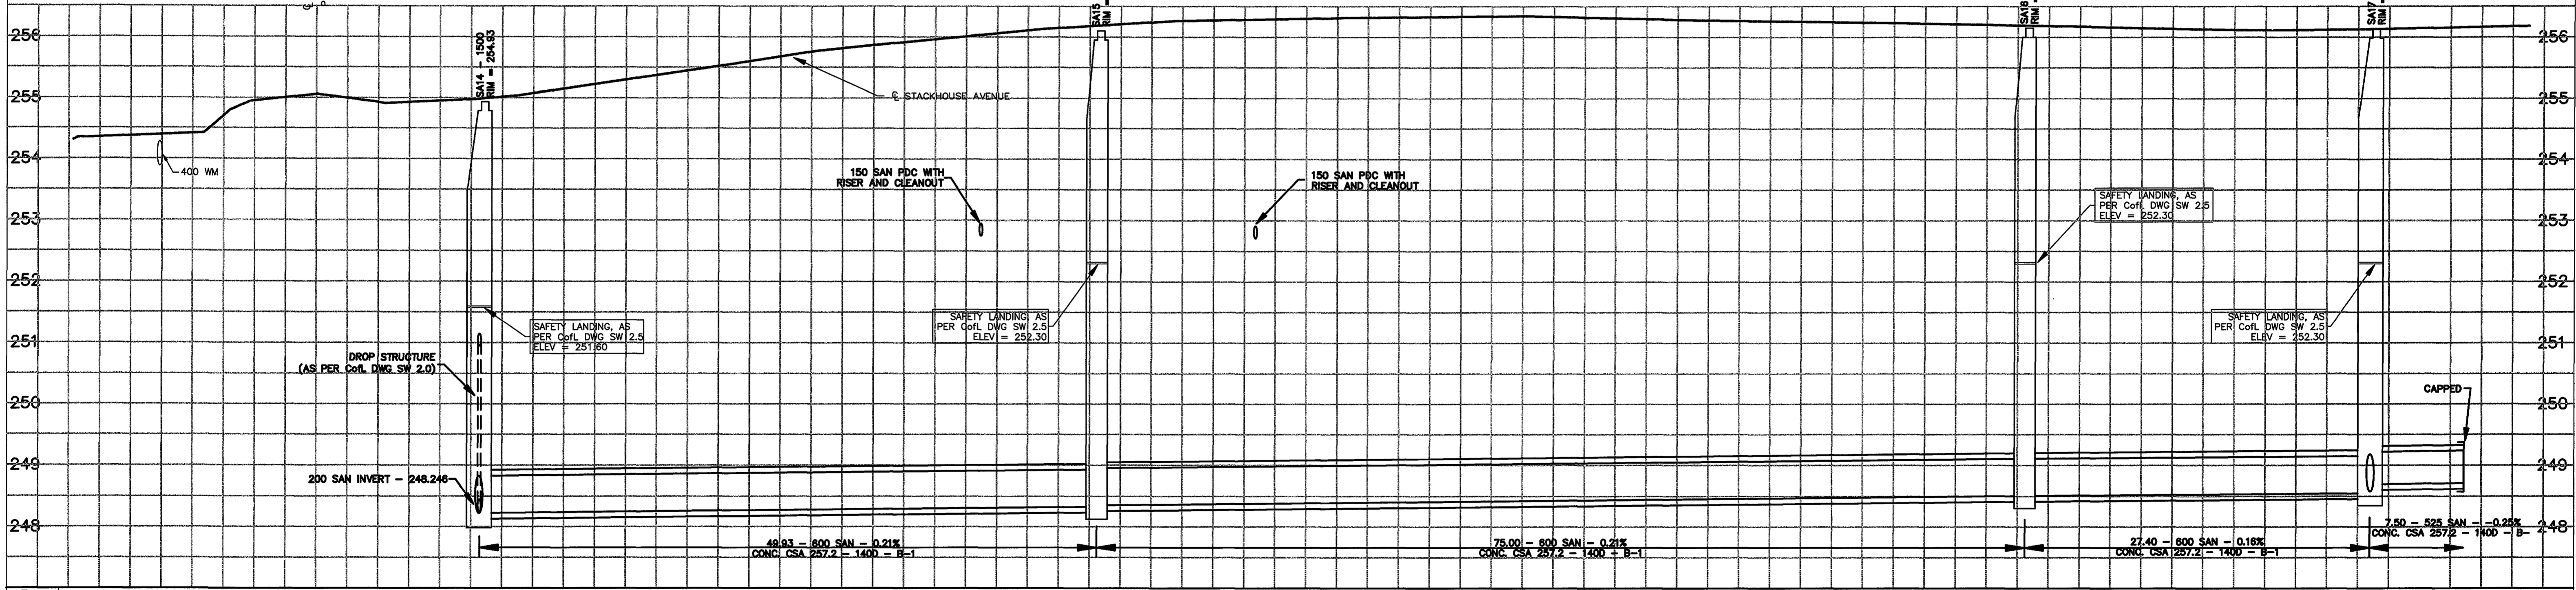




STATION	EXISTING SERVICES	DRAWING #, SOURCE	DATE	AS CONSTRUCTED SERVICES	COMPLETION	DETAILS	No.	REVISIONS	DATE	CONSULTANT
1+000		20154	APRIL 2008	SANITARY TRUNK SEWER, MHT'S & PDC'S	2011-11-04	DESIGN	1	ISSUED FOR REVIEW	2011-03-17	
1+006.8				SIDEWALKS	2011-09-31	DRAWN BY	2	ISSUED FOR REVIEW	2011-03-30	
1+010				CURB & GUTTER	2011-11-28	CHECKED	3	NOE SUBMISSION	2011-04-11	
1+020				PAVING - HLB BASE	2011-11-18	APPROVED	4	ISSUED FOR TENDER	2011-04-18	
1+040						DATE	5	PDC & PIPE CLASSIFICATION REVISED	2011-05-24	
1+060							6	ISSUED FOR CONSTRUCTION	2011-05-31	
1+067.5							7	AS CONSTRUCTED	2012-01-12	

STATION	SEWER INVERT	WATERMAIN ELEVATION
1+000		265.080
1+006.8	248.186 W 250.746 E 248.221 N	
1+020		
1+040		
1+060		
1+067.5	248.306 248.376	
1+100		
1+120		
1+140	248.504 248.574 248.504	
1+160		
1+175.5	248.549 S 248.579 E 248.692 N	

IBI GROUP

IBI Group
203 - 350 Oxford Street West
London ON N6H 1T3 Canada

tel 519 472 7328
fax 519 472 9354

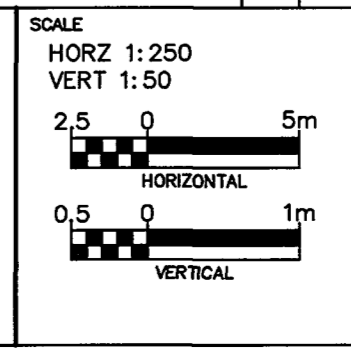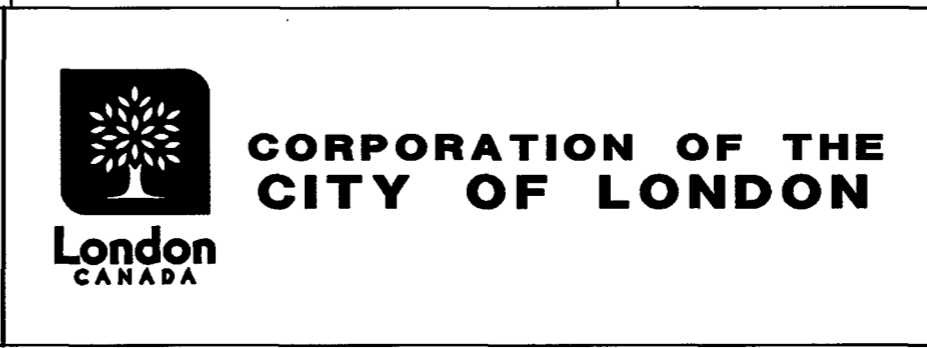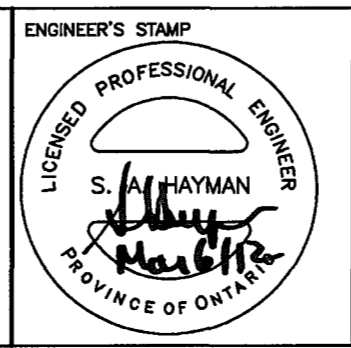

TITLE
STONEY CREEK SANITARY TRUNK SEWER
ES4402

STACKHOUSE AVENUE
FROM FANSHAWE PARK ROAD TO FUTURE STREET

PROJECT No. **12021**
SHEET No. **PP-07**
PLAN FILE No. **23144**



Sanitary Service Design Sheet

City of London

Residential Population Densities

(A) Area Basis

Low Density Residential (Single Family/Semi-Det: = 30 Units/hectare @ 3 people/unit

Medium Density Residential (Multi-Family/Tow =75 Units/hectare @ 2.4 people/unit

High Density Residential (Apartment Buildings) =150-300 Units/hectare @ 1.6 people/unit

Commercial = 100 people/hectare

Daily Flow (L/cap/day) 250

Daily Flow (L/cap/day) 230

Sewage Infiltration (Litres/hectare/day) 8640

Harmon Formula (Peaking Factor)

$M = (1 + 14/(4+P^{0.5}))$

Uncertainty Factor 1.1

Date: May 11, 2022

Job Number: SBM-22-1218

Client: Brock Development

Project: Proposed Residential Development

Location: 1170 Fanshawe Park Road E.

Designed By: RS

Reviewed By: RF

Location			Area		Population					Sewage Flows				Sewer design				
Area No.	From MH	To MH	Delta Hectare	Total Hectare	*No. of Units	**People Per Unit	People Per Hectare	Delta Pop.	Total Pop.	Harmon Peaking Factor	Infiltr L/S	Sewage L/S	Total L/S	n	Pipe Slope %	Dia. mm	Capacity L/S	Velocity m/s
***Upstream Conditions Area 4d	SA15	SA14	0.87	374.19	0	0.0	100	87	22253	2.61	37.42	184.58	222.00	0.013	0.16%	600	245.75	0.87
***Existing Condition (A4e) Area 4e	SA15	SA14	0.71	374.9	0	0.0	60	42.6	22296	2.61	37.49	170.09	207.58	0.013	0.16%	600	245.75	0.87
Proposed Condition Medium Density	SA15	SA14	0.37	0.37	26	2.4		62.4	63	4.29	0.04	0.79	0.83	0.013	7.30%	150	41.17	2.33
***Downstream Conditions Area 4e	SA15	SA14	0.71	375.61	26	2.4	60	62.4	22379	2.60	37.56	170.61	208.17	0.013	0.16%	600	245.75	0.87




*Based on Proposed site plan by Brock Development Group

**Medium Density Residential (Multi-family/Townhouse) 75 Units/hectare @ 2.4 people/unit

***Based on City of London Record Drawing 23144

LEGEND

- 10 STORM MANHOLE
- OGS OIL GRIT SEPARATOR
- 87.0-300 ST-0.54% STORM SEWER
- EXISTING STORM MANHOLE
- 300 ST EXISTING STORM SEWER
- - - STORM CATCHMENT AREA
- A-1 1.06Ha STORM AREA No.
- - - STORM CATCHMENT AREA
- C=0.70 RUNOFF COEFFICIENT

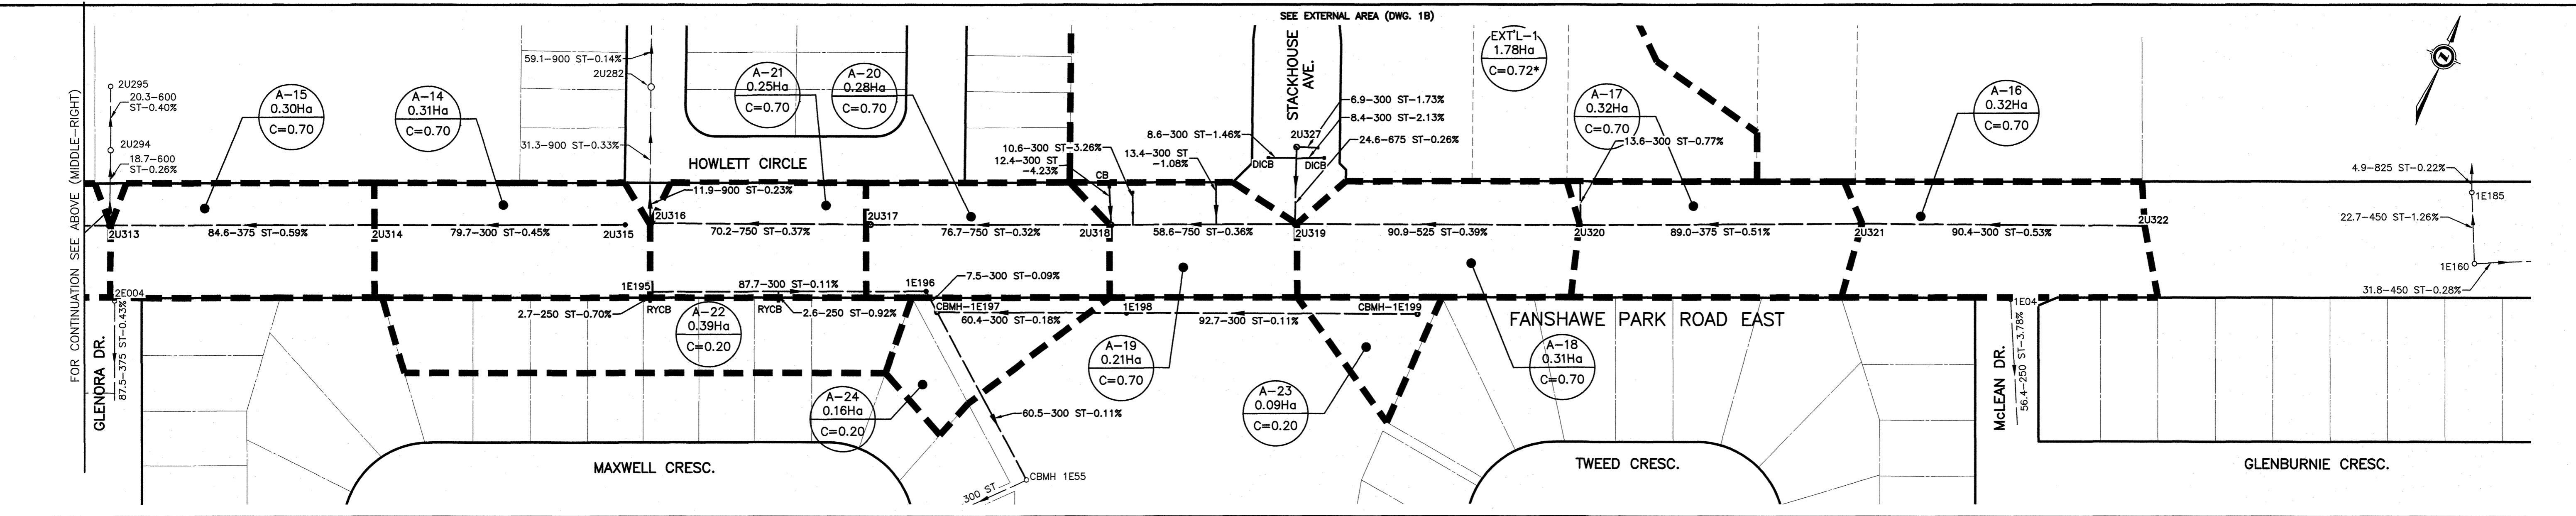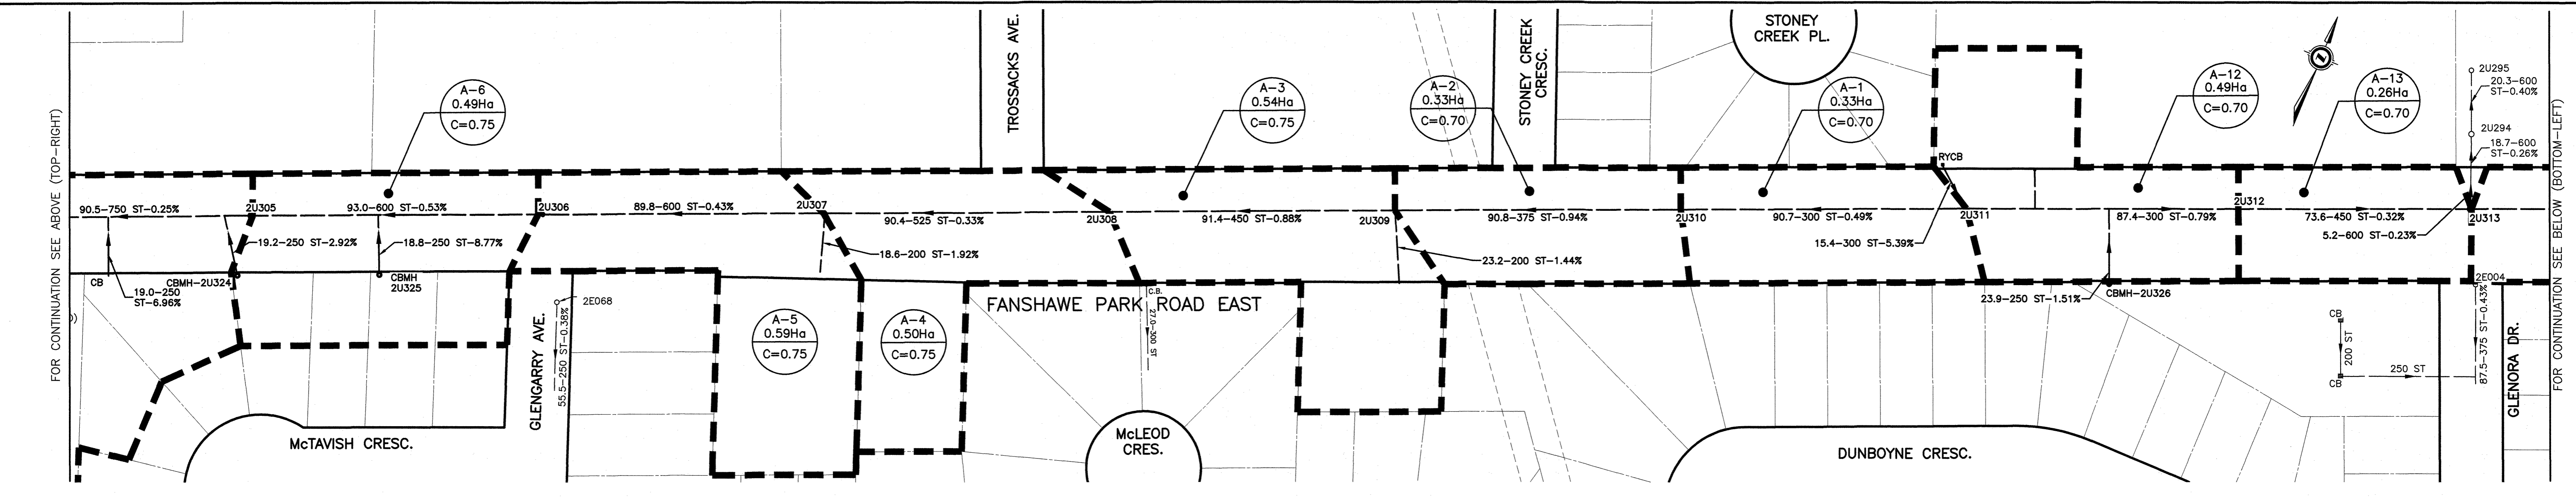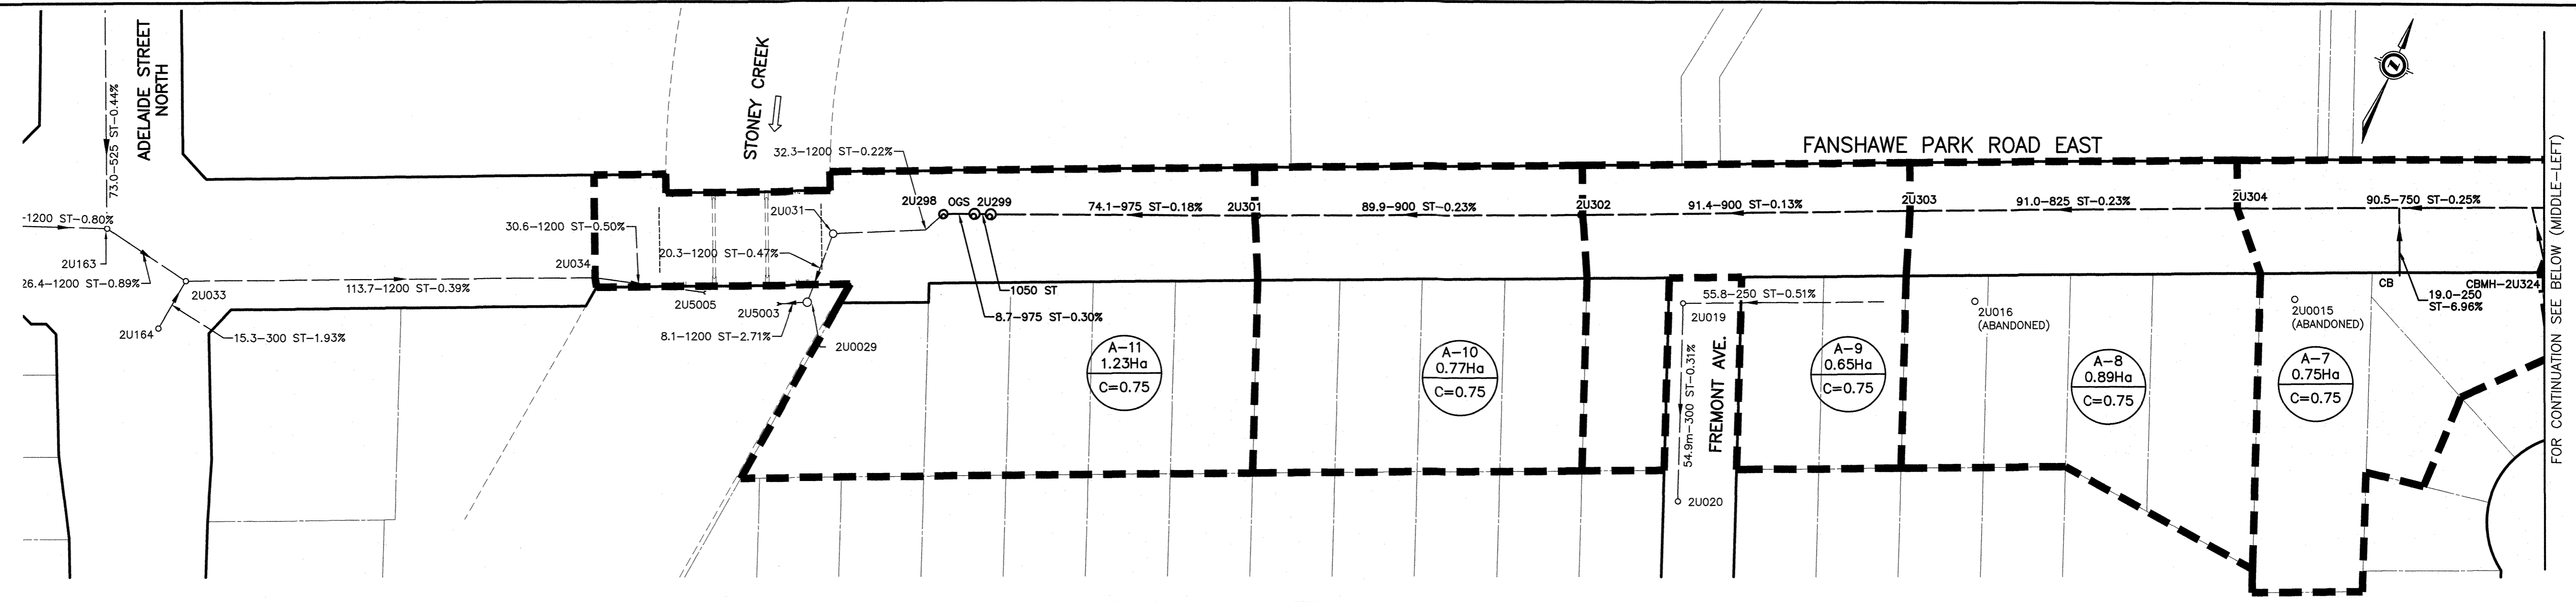

EXISTING SERVICES	DRAWING #, SOURCE	DATE	AS CONSTRUCTED SERVICES	COMPLETION	DETAILS	No.	REVISIONS	DATE	CONSULTANT
					DESIGN	DCC/RJS	1. ISSUED FOR 50% REVIEW	MARCH 27/15	AECOM
					DRAWN BY	RJS	2. ISSUED FOR 80% REVIEW	AUGUST 21/15	AECOM
					CHECKED	JJK	3. ISSUED FOR 100% REVIEW	NOVEMBER 4/15	AECOM
					APPROVED	DCC	4. ISSUED FOR TENDER	DECEMBER 2/15	AECOM
					DATE	NOV. 2014	5. RECORD DRAWING	FEBRUARY 24/17	AECOM

CONSULTANT OR DIVISION

AECOM
London, Ontario
519.673.0510

ENGINEER'S STAMP

D.C. CARTER
Professional Engineer
No. 17177
Province of Ontario

CORPORATION OF THE CITY OF LONDON
London CANADA

SCALE

SCALE-1:1000

10 0 20m

FANSHAW PARK ROAD IMPROVEMENTS
ADELAIDE STREET TO McLEAN DRIVE

STORM AREA PLAN

PROJECT No. 60333430

SHEET No. 1A

27101

Runoff Coefficient Calculations

DATE: May 3, 2022
 JOB No.: SBM-22-1218

Client: Brock Development Group Inc.
 Project: Proposed Residential Development
 Location: 1170 Fanshawe Park Road, London, Ontario

PRE-DEVELOPMENT AREA (TOTAL SITE)

	*Area (m ²)	C	AxC
Total Area:	3722.04		
Building Area:	426.10	0.9	383.49
Concrete/Asphalt:	168.00	0.9	151.2
Gravel:	0.00	0.7	0
Landscaped/Open:	3127.94	0.2	625.588
Totals:	3722.04		1160.278
$C_{eq} = \frac{\sum(A \cdot C)}{\sum(A)}$	0.40		
$C_{allowable}$	0.72	City record drawing 27102	

POST-DEVELOPMENT AREA (TOTAL SITE)

	*Area (m ²)	C	AxC
Total Area:	3722.04		
Building Area:	954.82	0.9	859.338
Green Roof:	0.00	0.6 *	0
Concrete/Asphalt:	1599.53	0.9	1439.577
Gravel:	0.00	0.7	0
Landscaped/Open:	1167.69	0.4 *	467.076
Totals:	3722.04		2765.991
$C_{eq} = \frac{\sum(A \cdot C)}{\sum(A)}$	0.74		

* Pre-Development Areas are approximate and taken from CAD drawings - City of London Mapping - Topo 2015 - 2D - 7964t_15